




図面名	本館棟 2 階平面図
縮 尺	S=1:300 (A3)

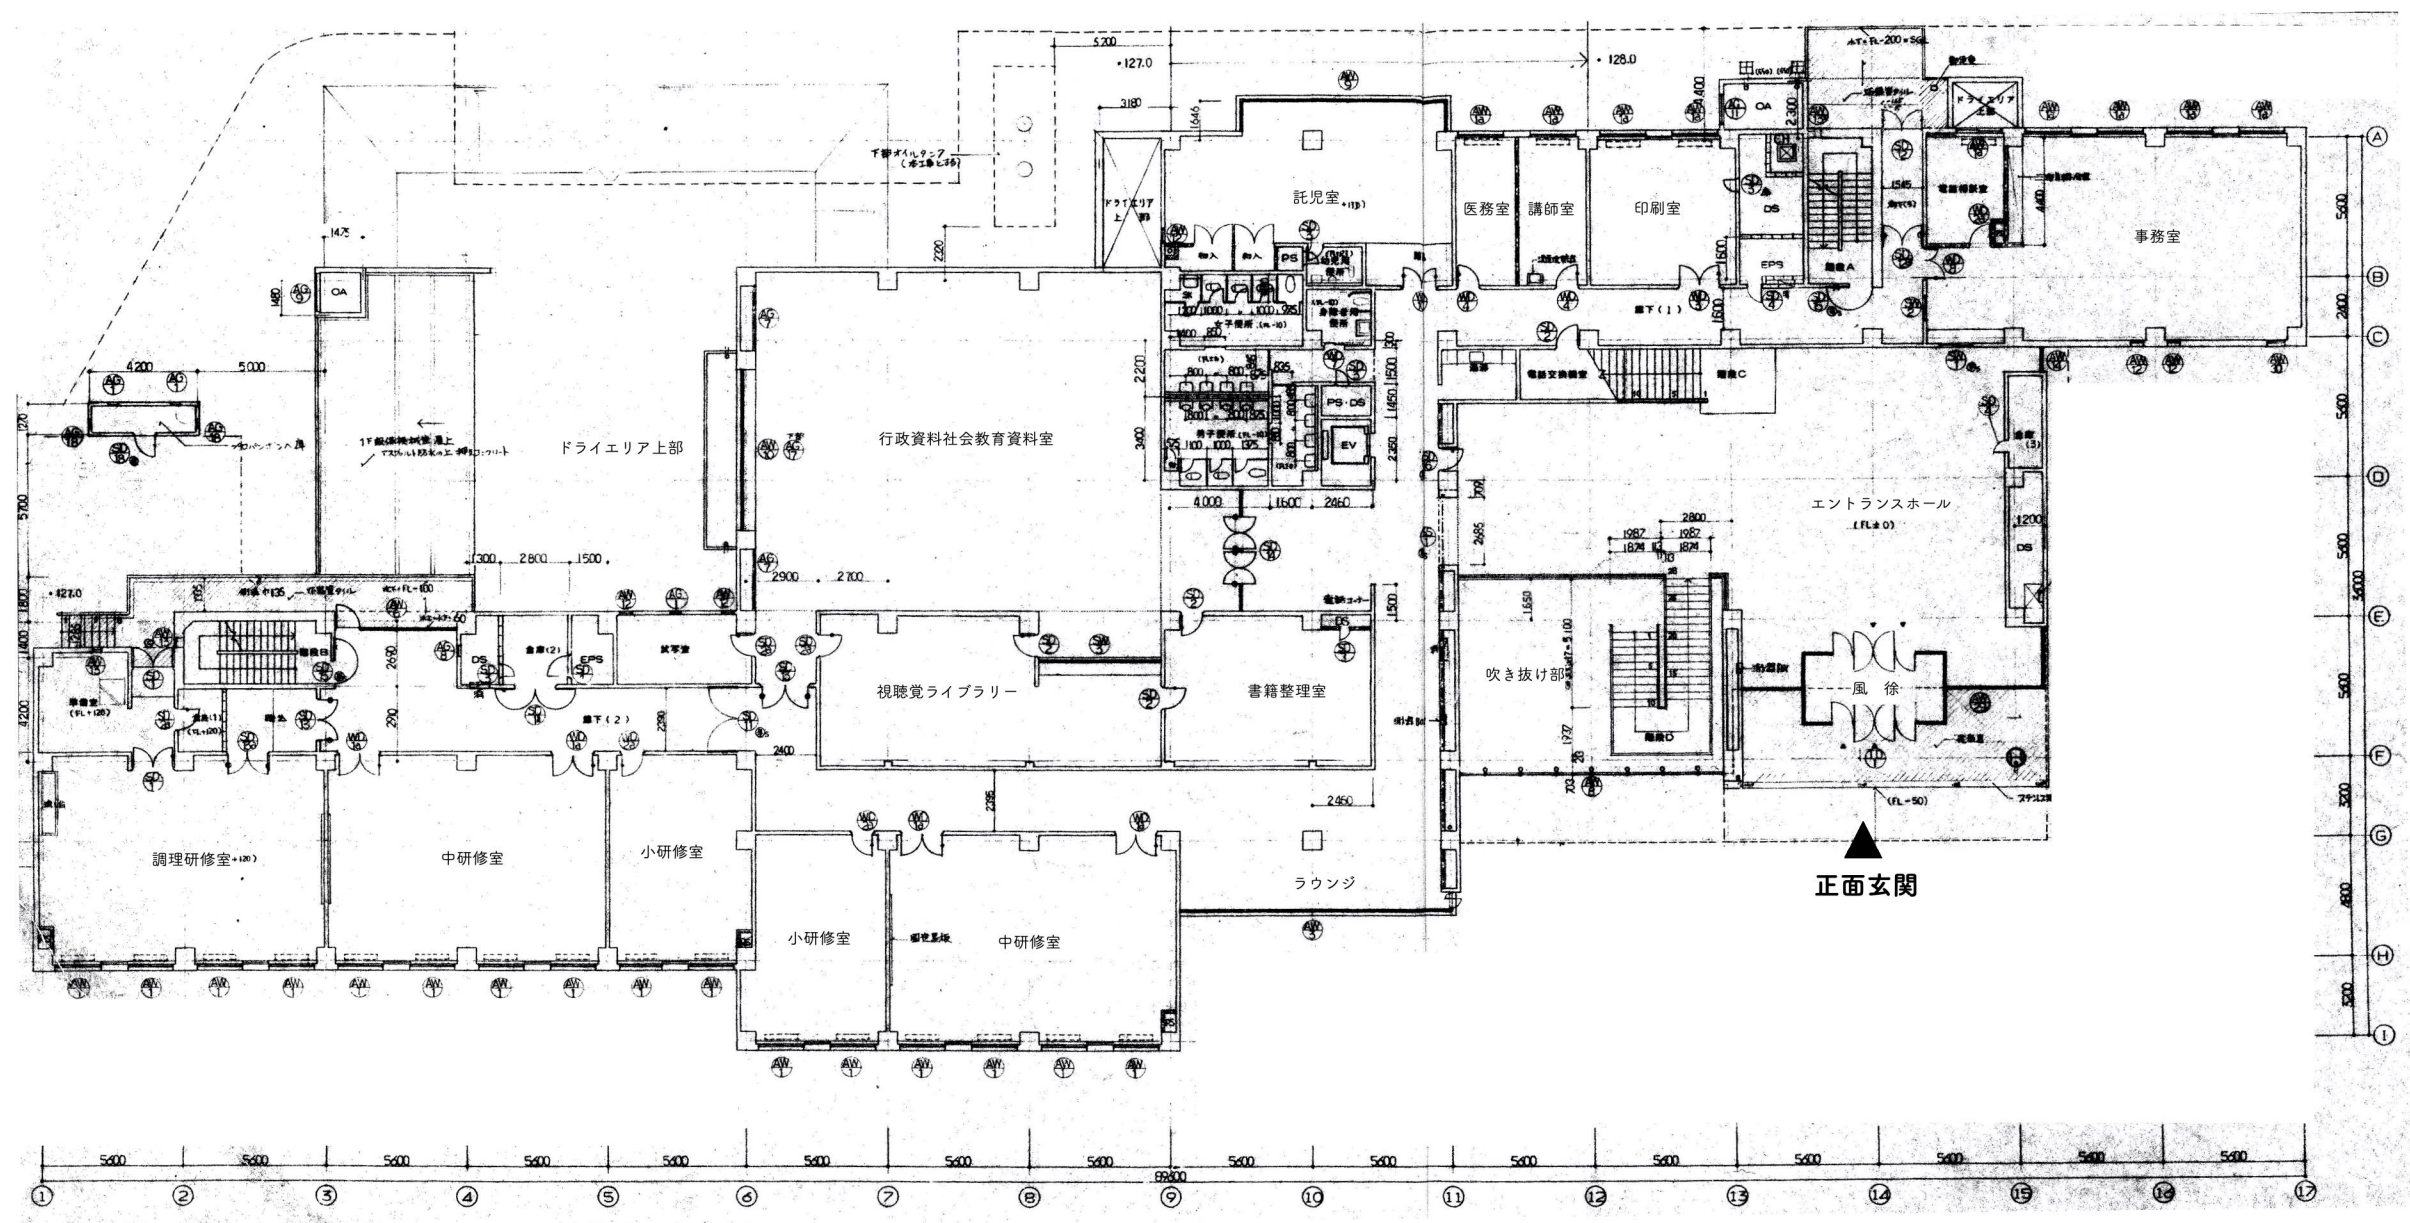

昭和58年竣工図による参考図


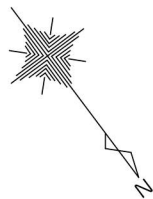


図面名	本館棟 3 階平面図
縮 尺	S=1:300 (A3)

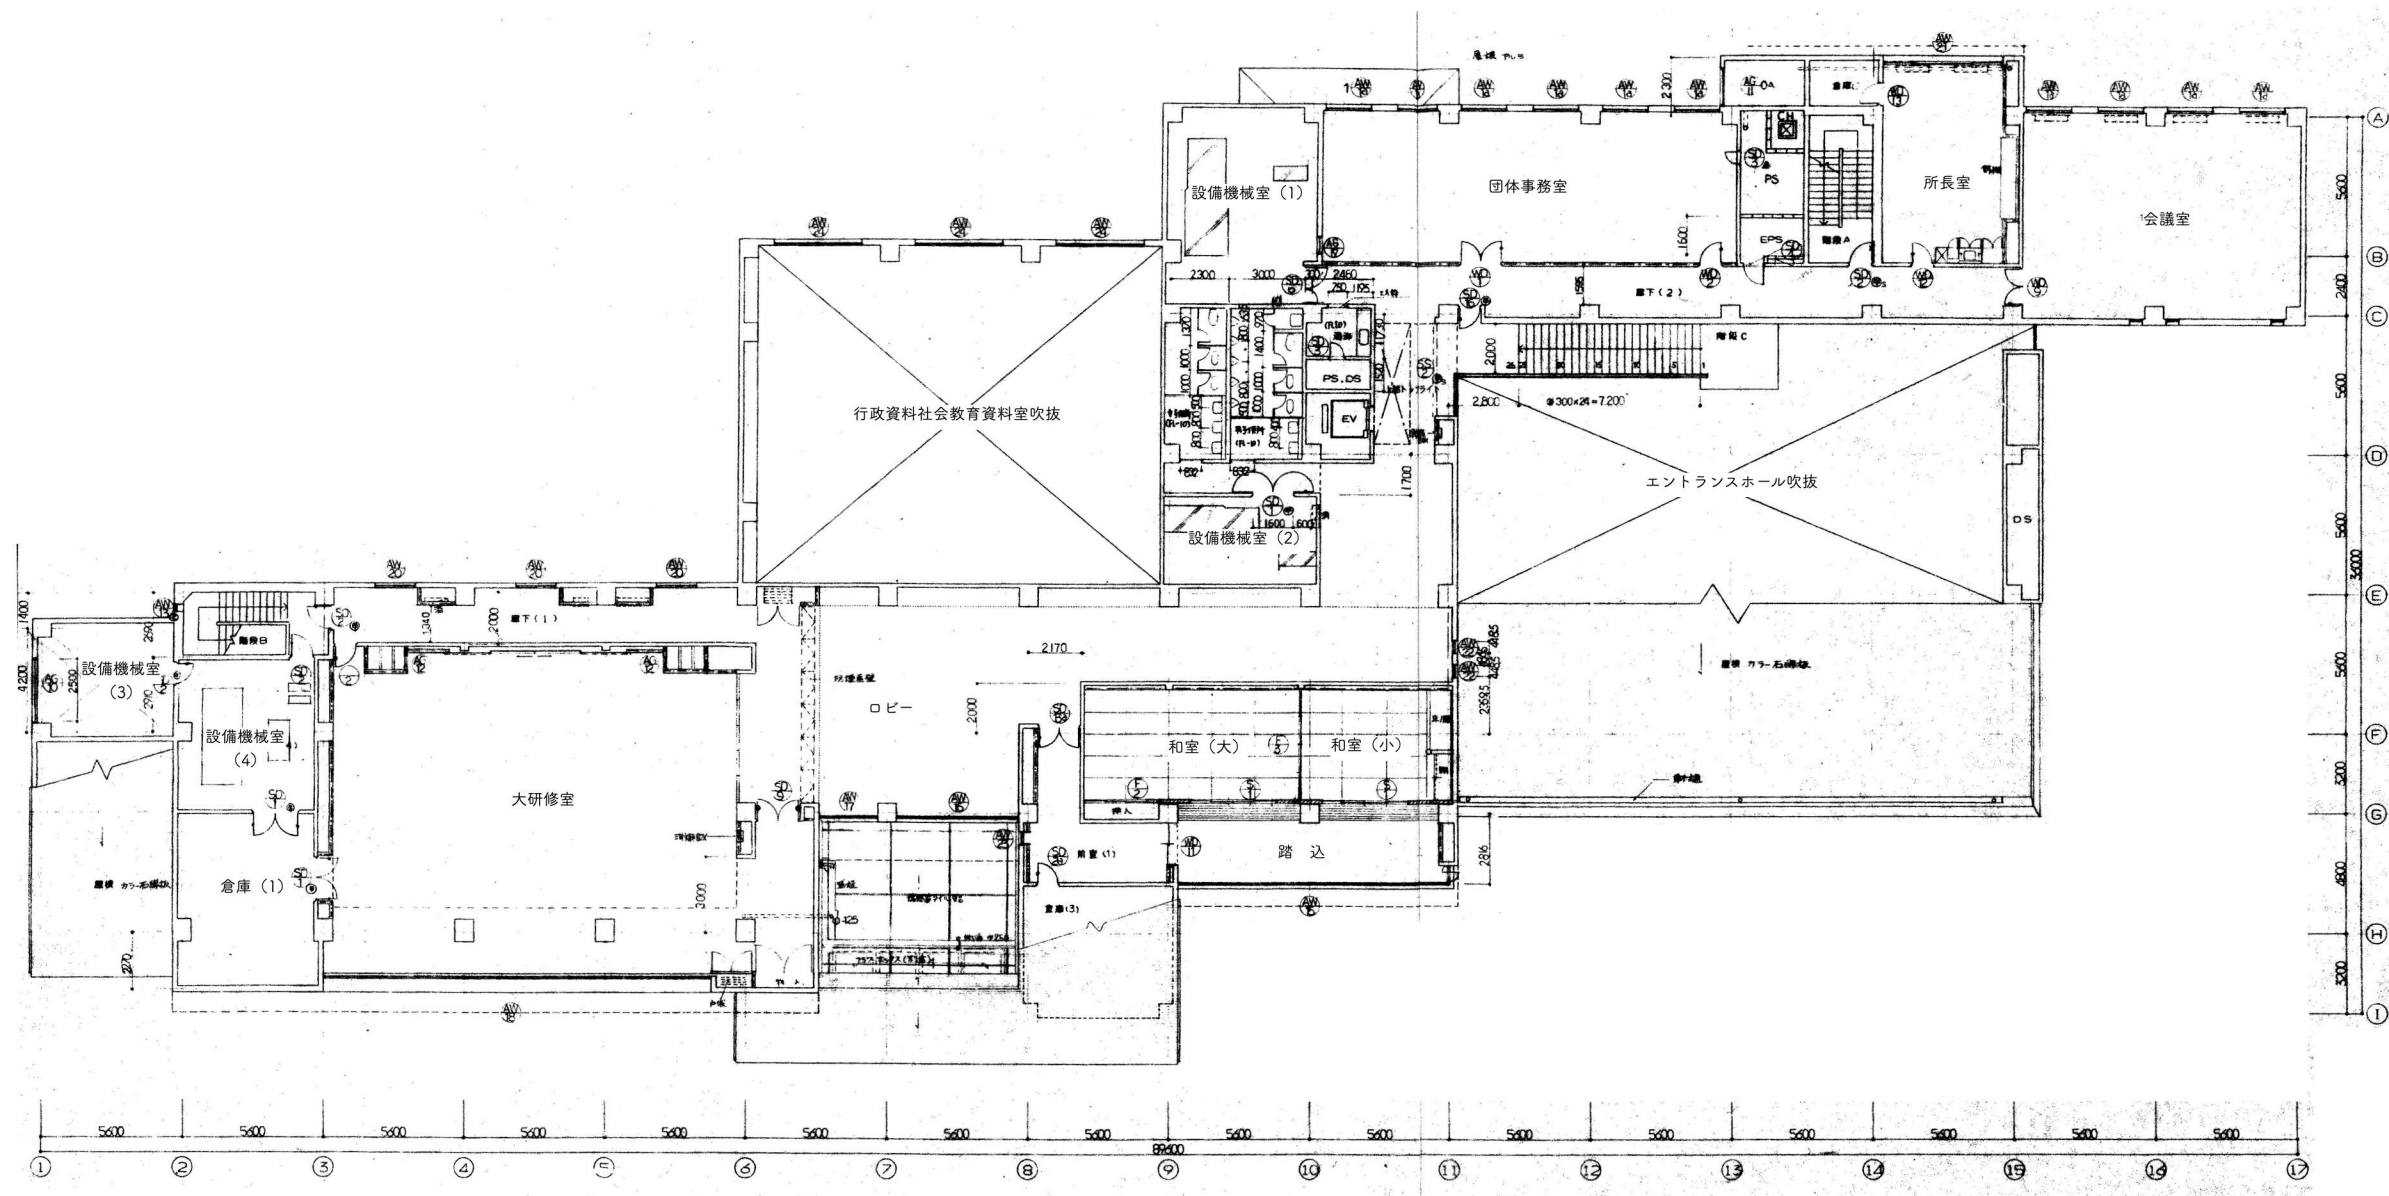


昭和58年竣工図による参考図


図面名	本館棟PH階平面図
縮 尺	S=1:300 (A3)

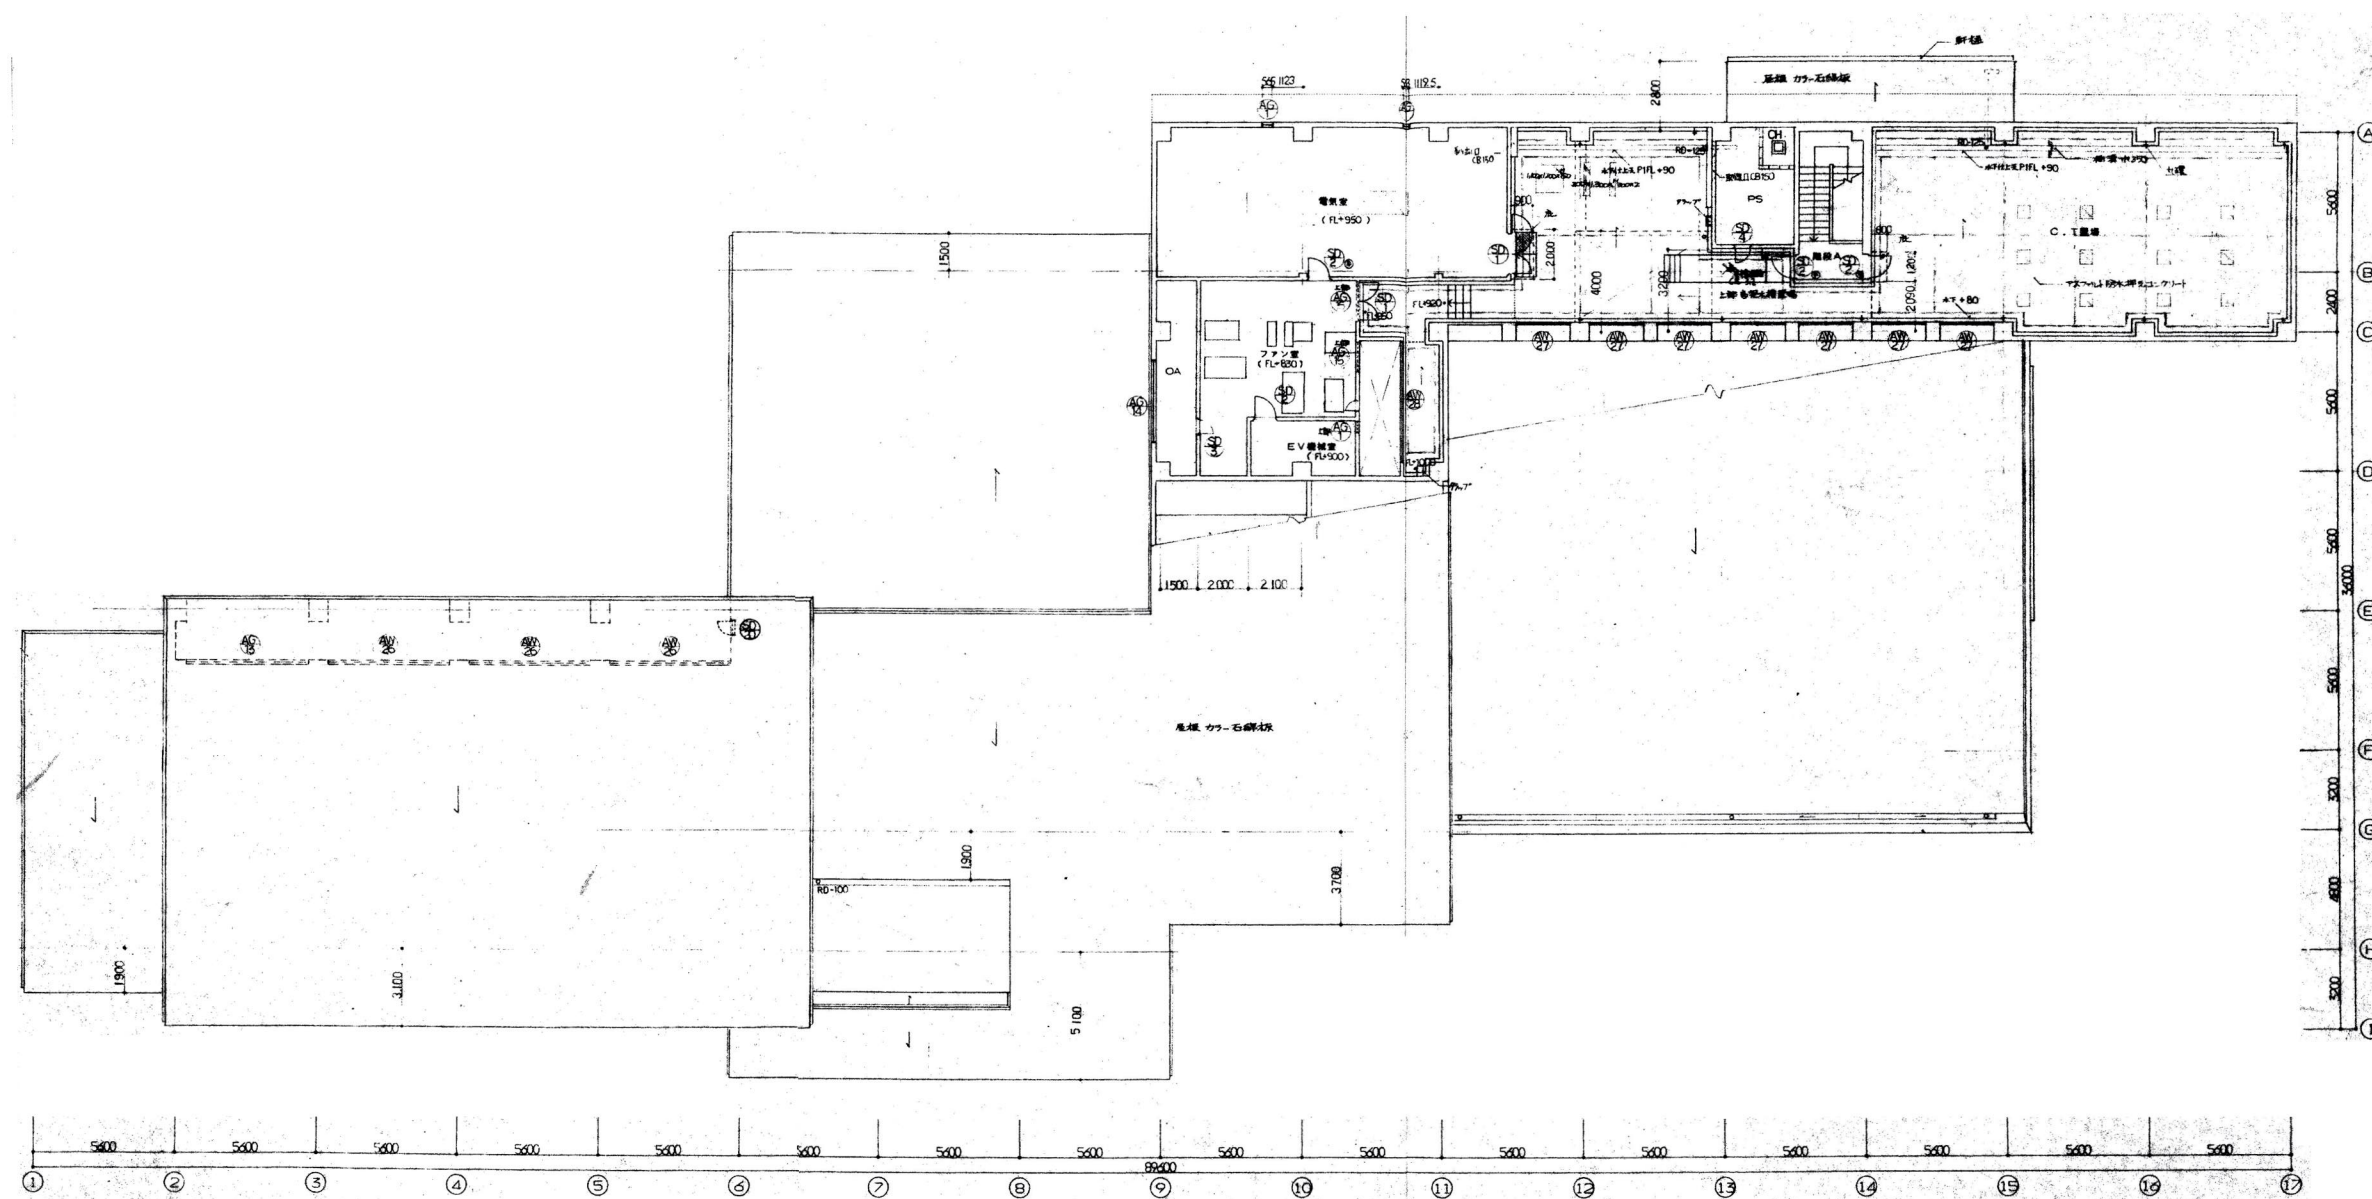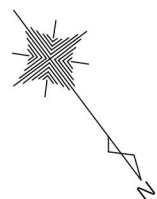

図面名	本館棟立面図
縮 尺	S=1:400 (A3)

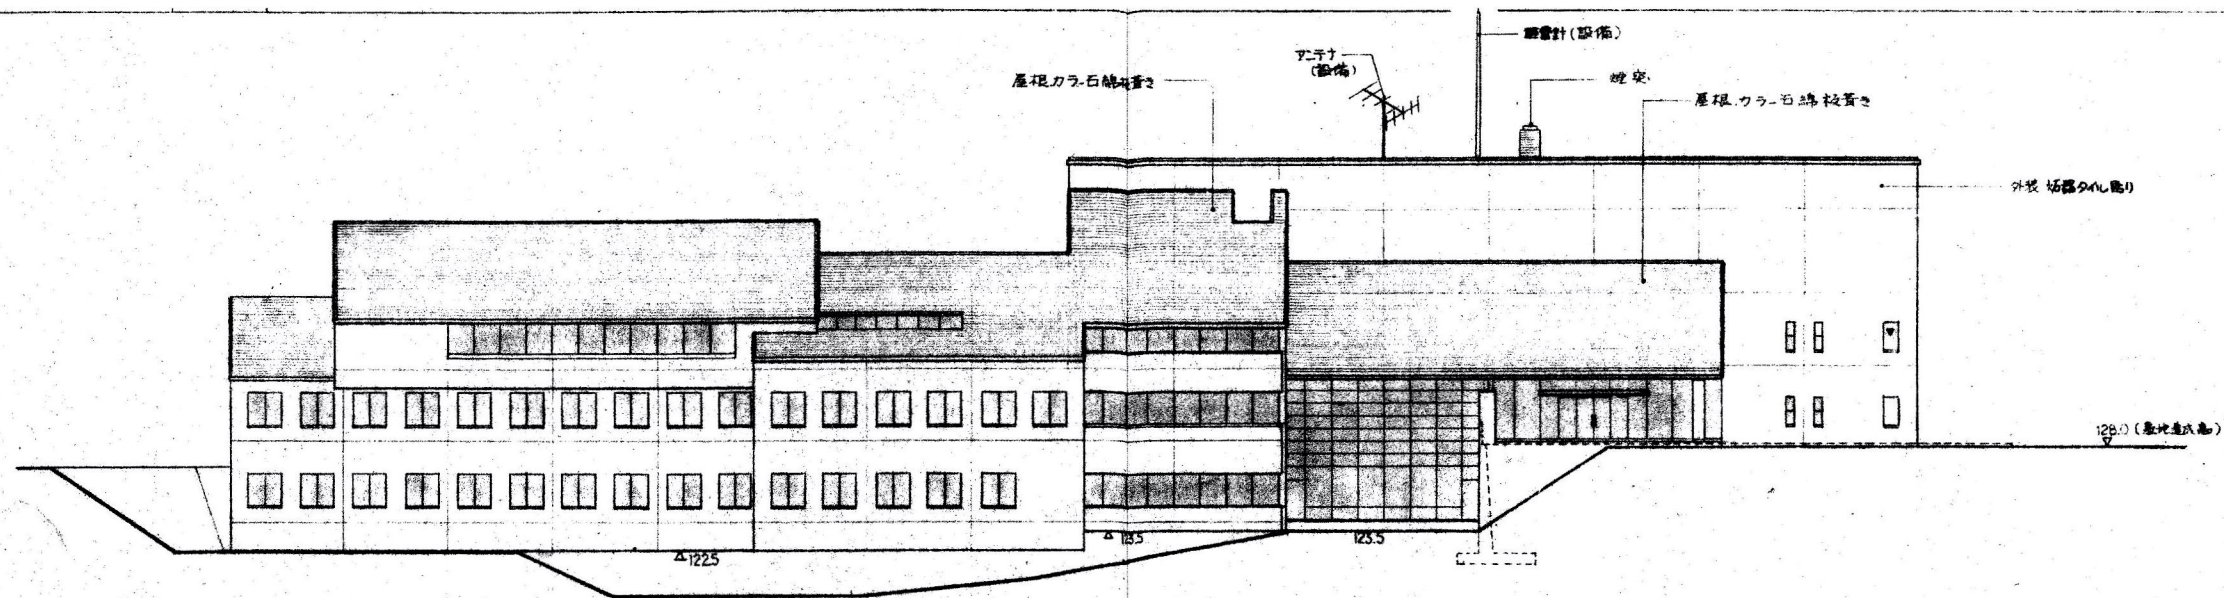


東立面図

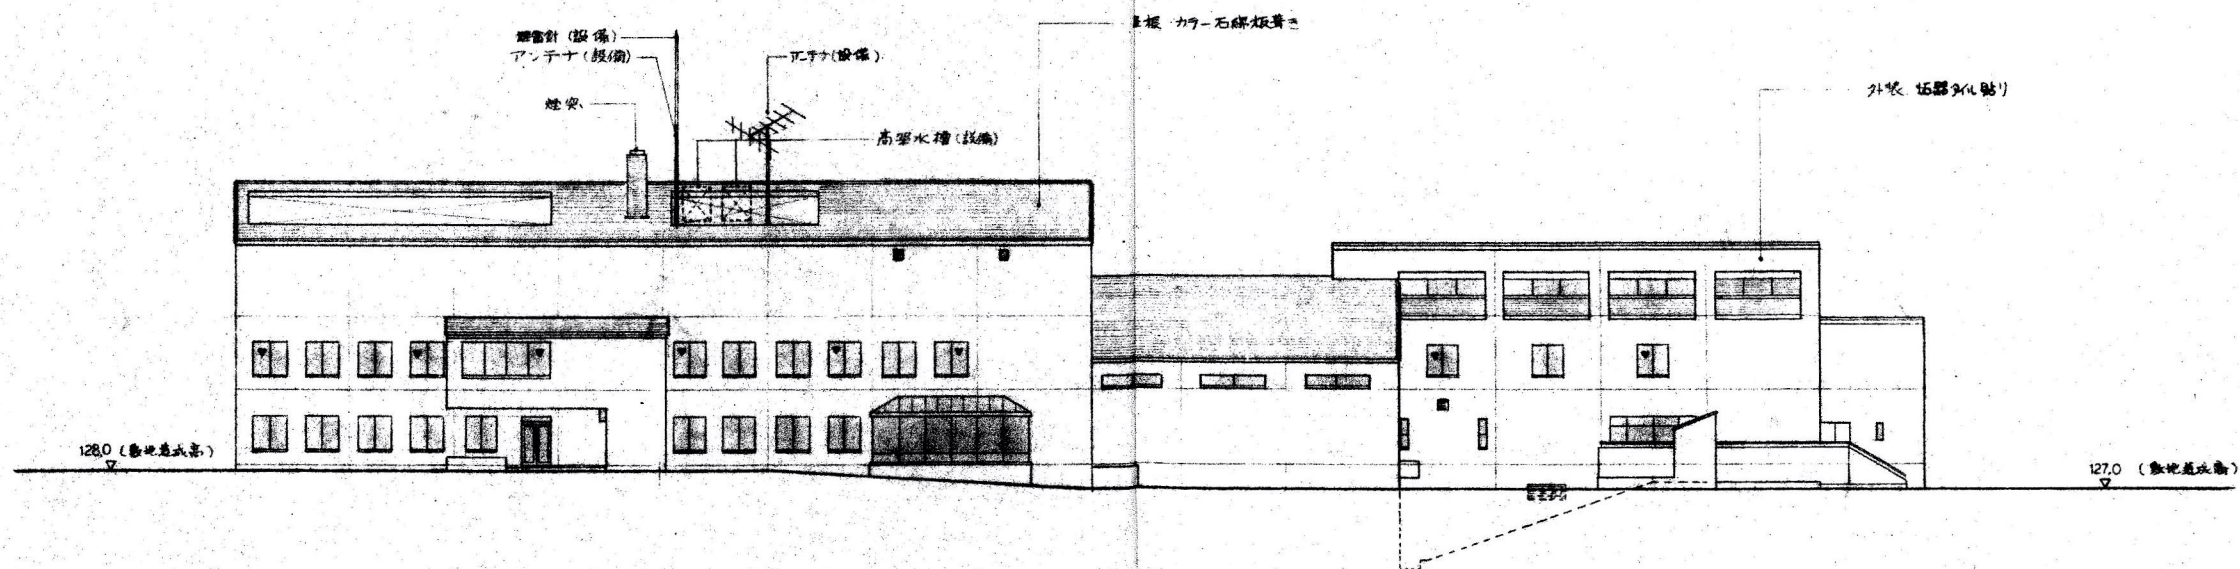


西立面図


図面名	本館棟立面図・断面図
縮 尺	S=1:400(A3)

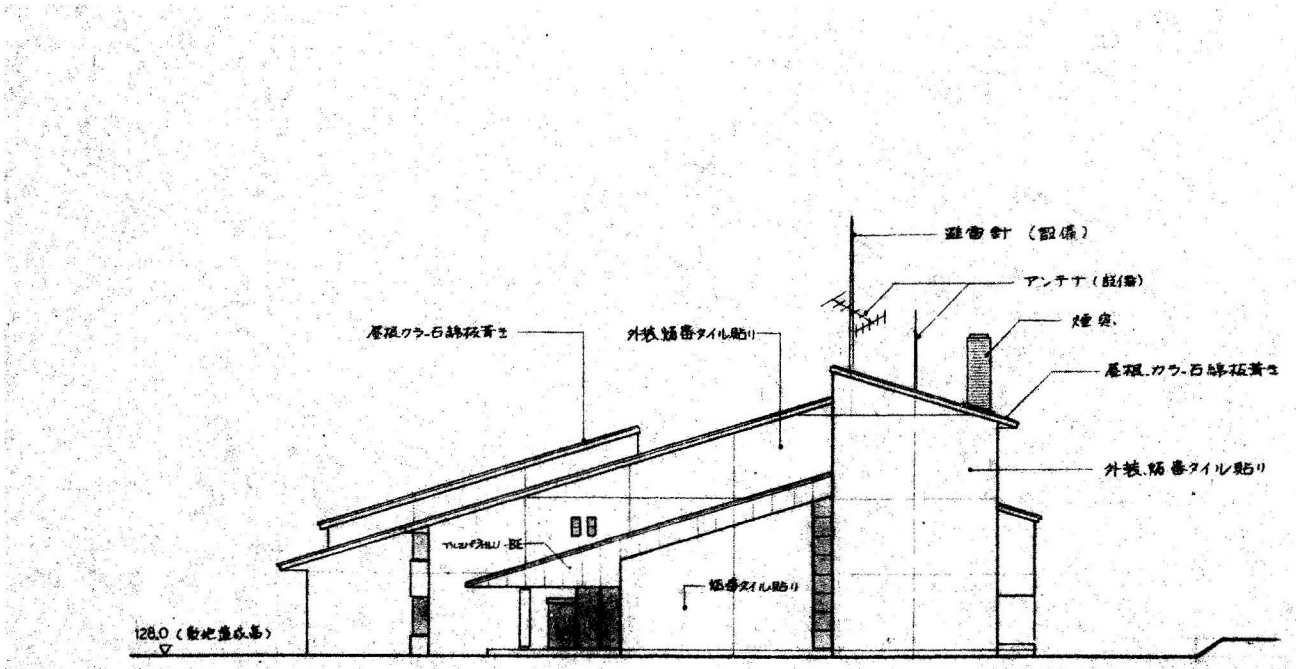


北立面図

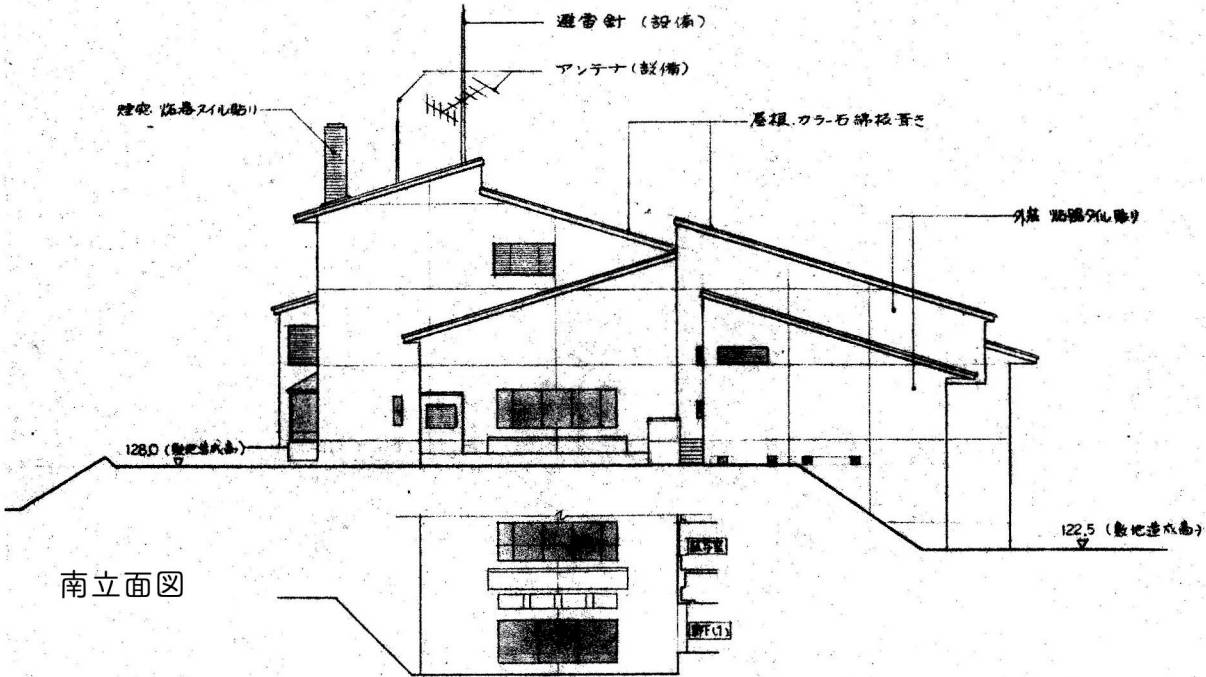

南立面図

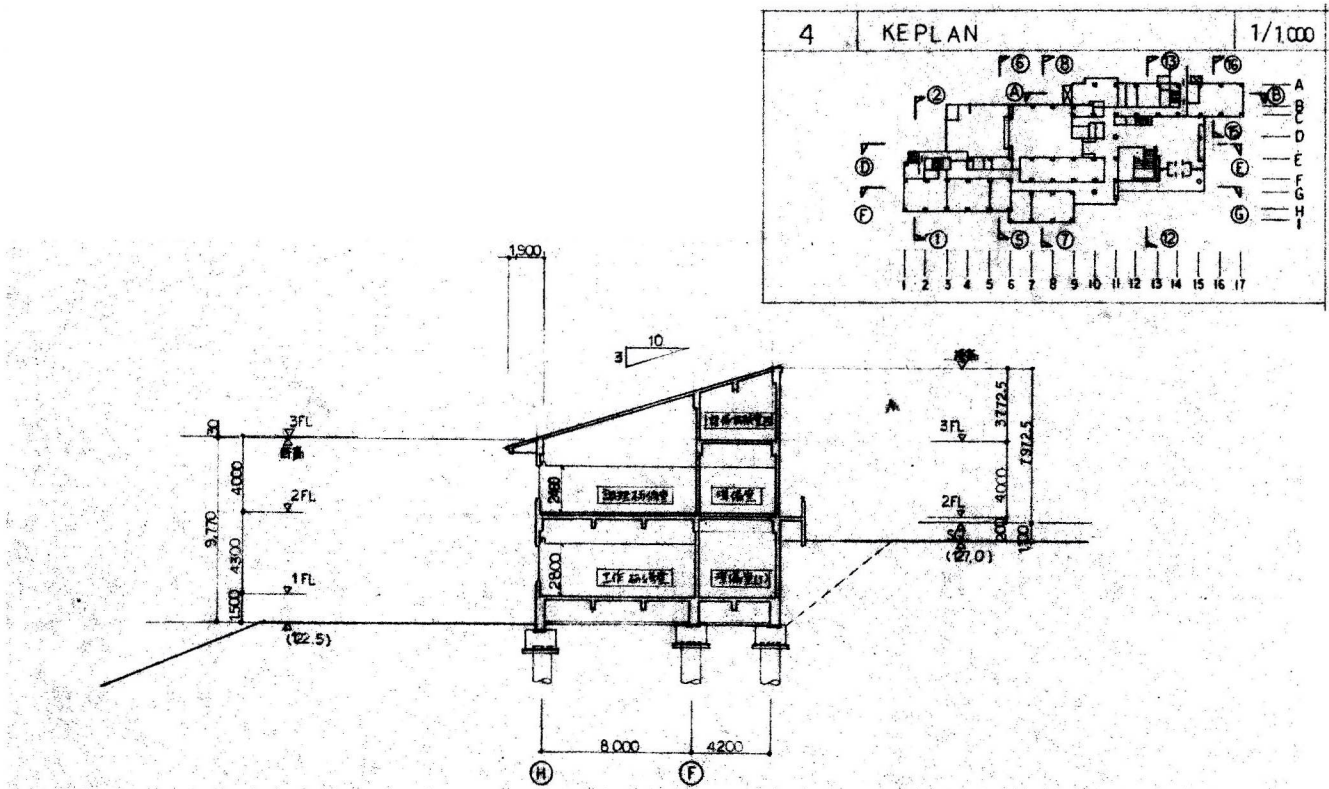


①～②断面図

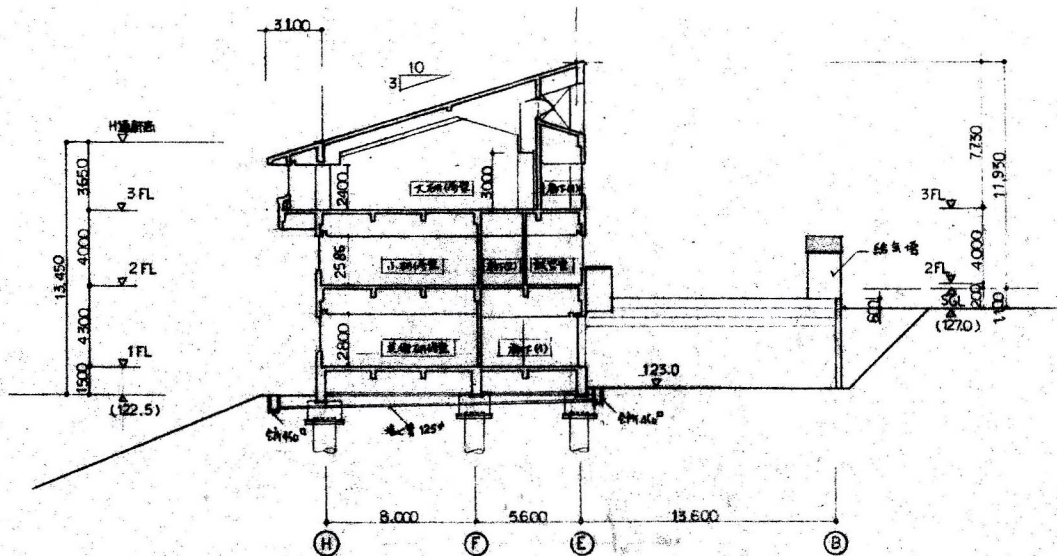


⑤～⑥断面図


図面名	本館棟断面図
縮 尺	S=1:400(A3)

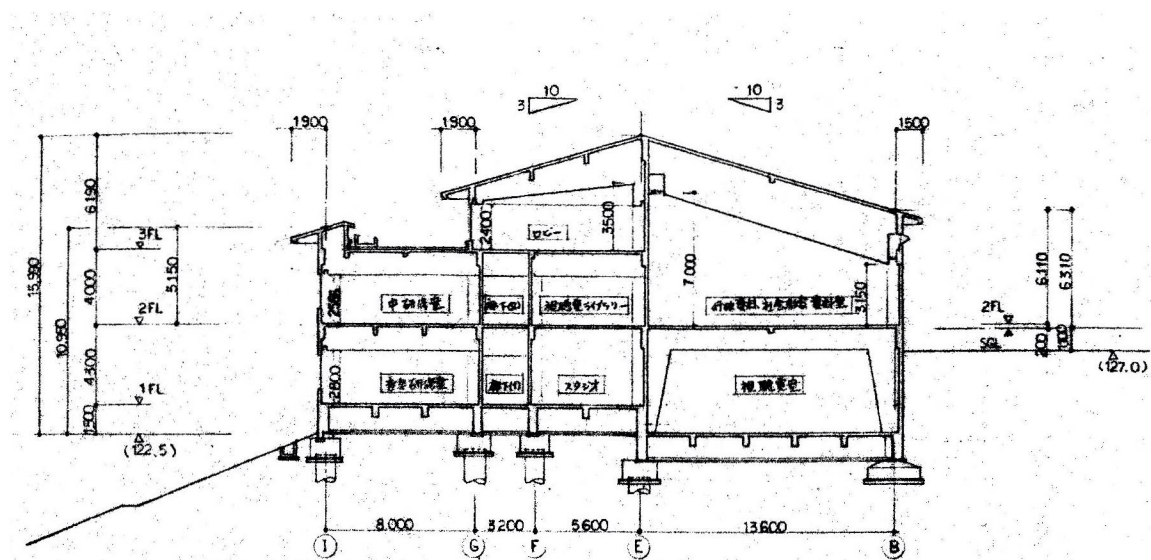


⑦～⑧断面図

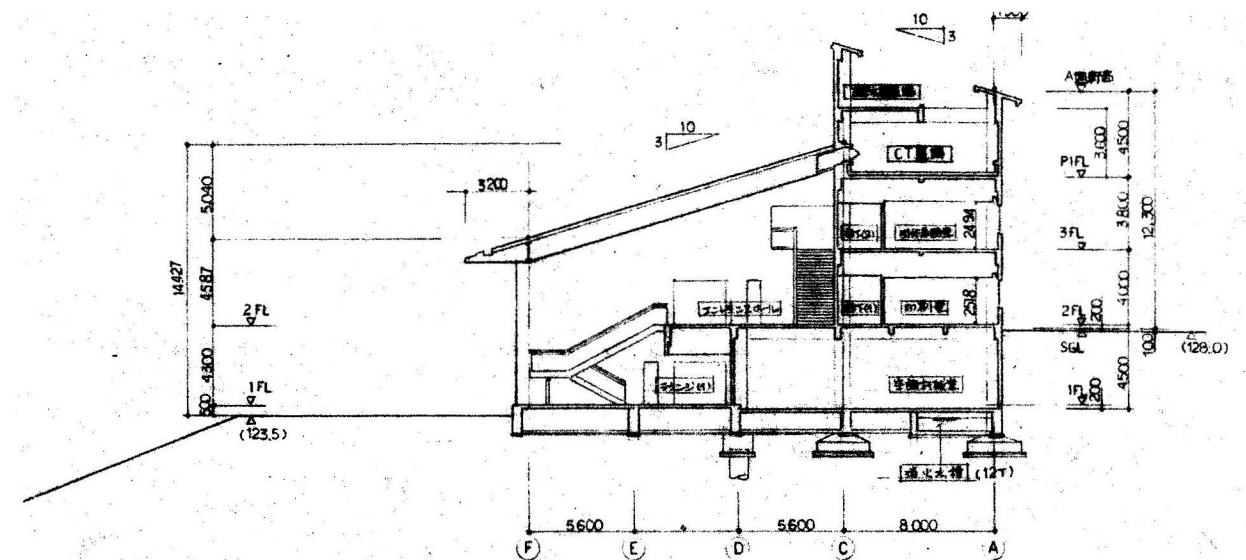


⑫～⑬断面図

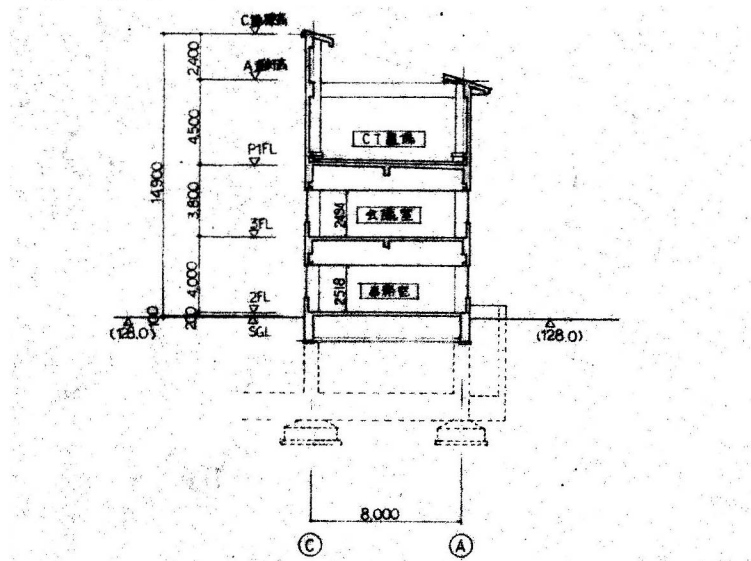


⑮～⑯断面図

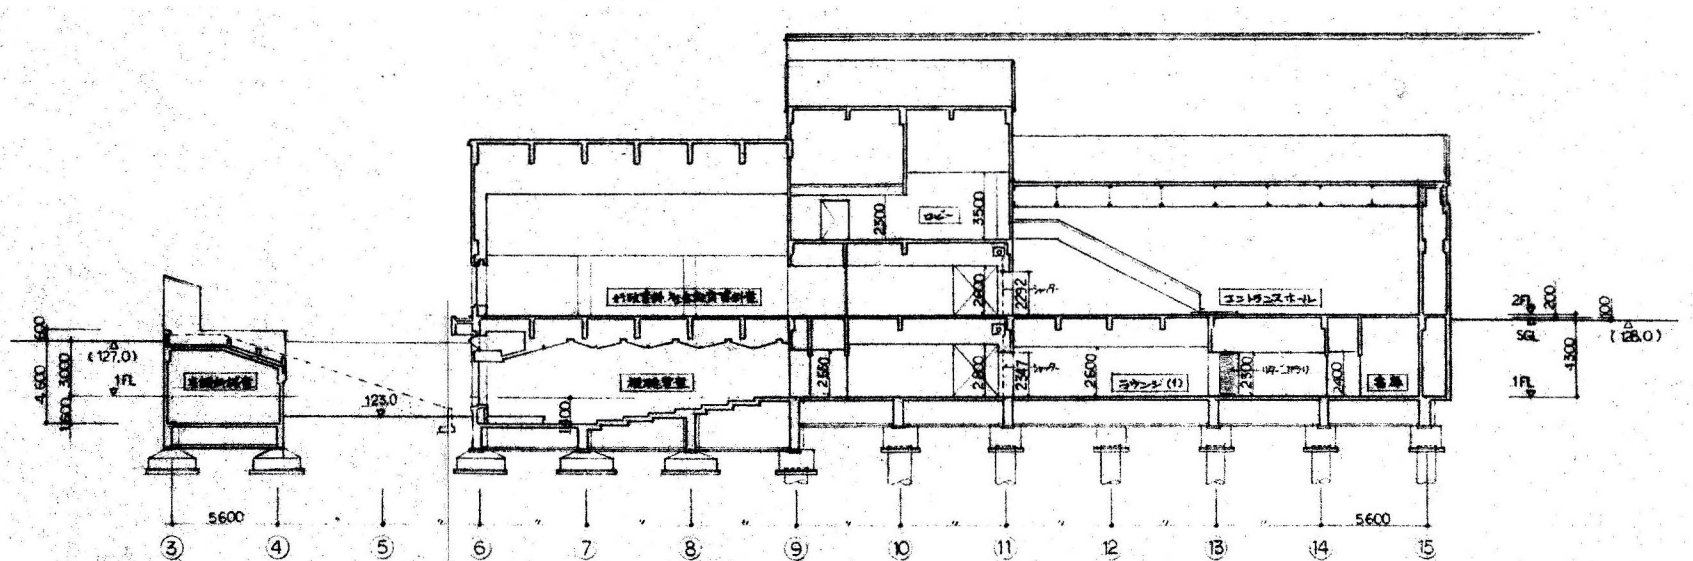


④～⑤断面図

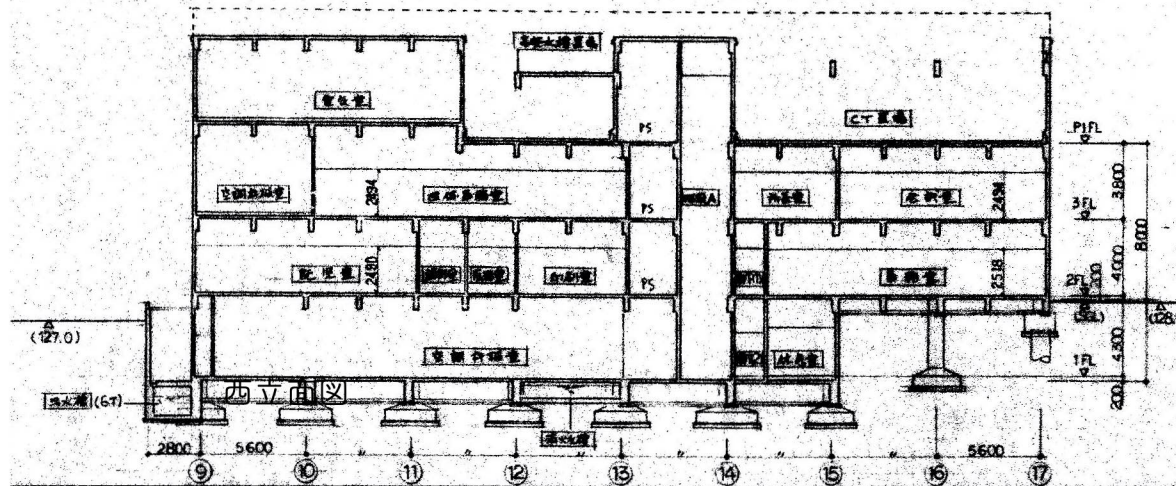



①～②断面図

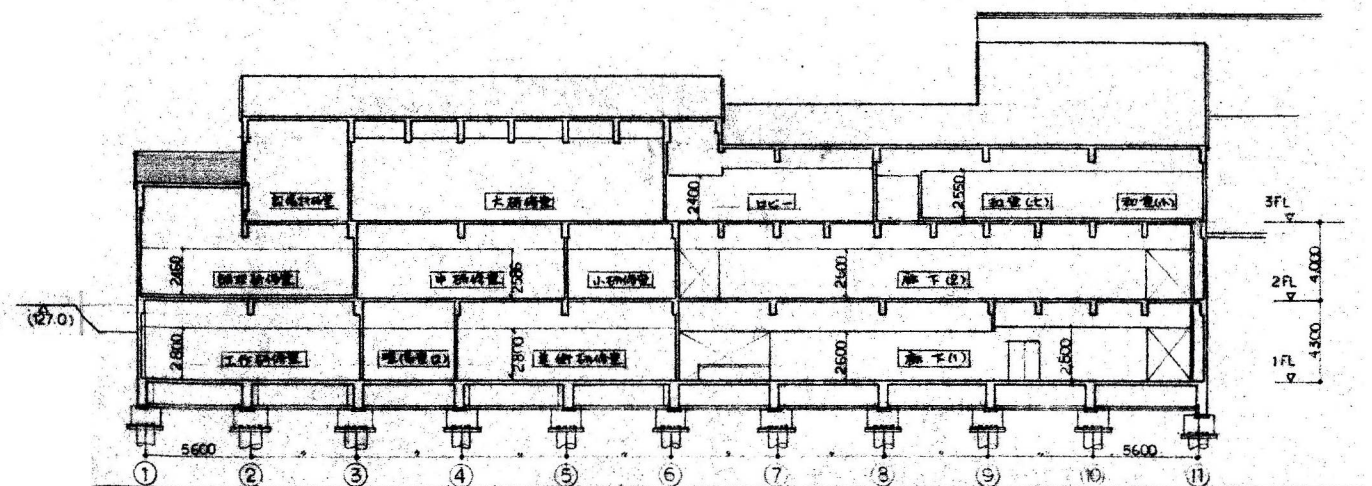

⑥～⑦断面図

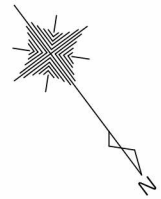

図面名	本館棟求積図
縮 尺	S=1:1000(A3)

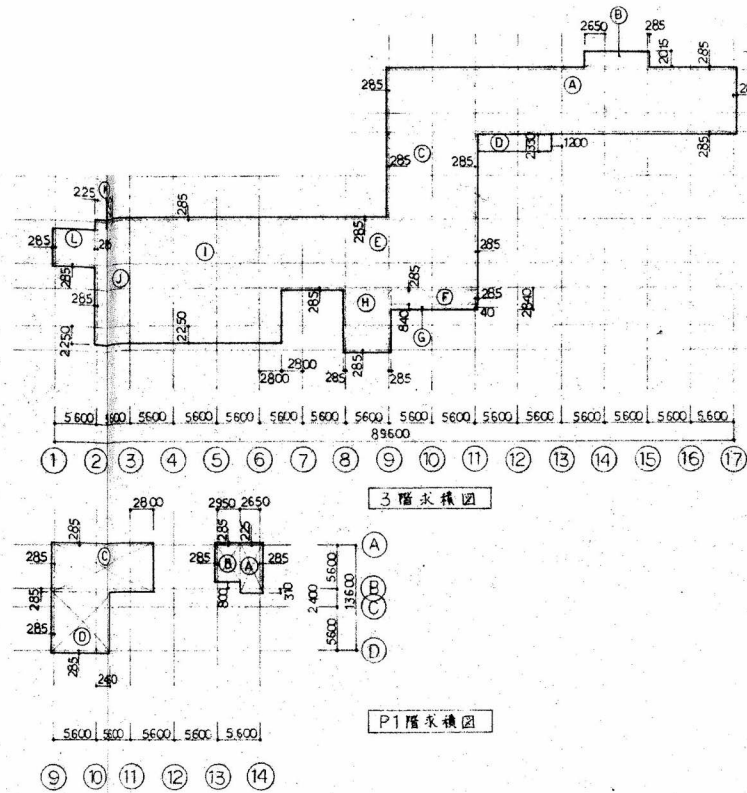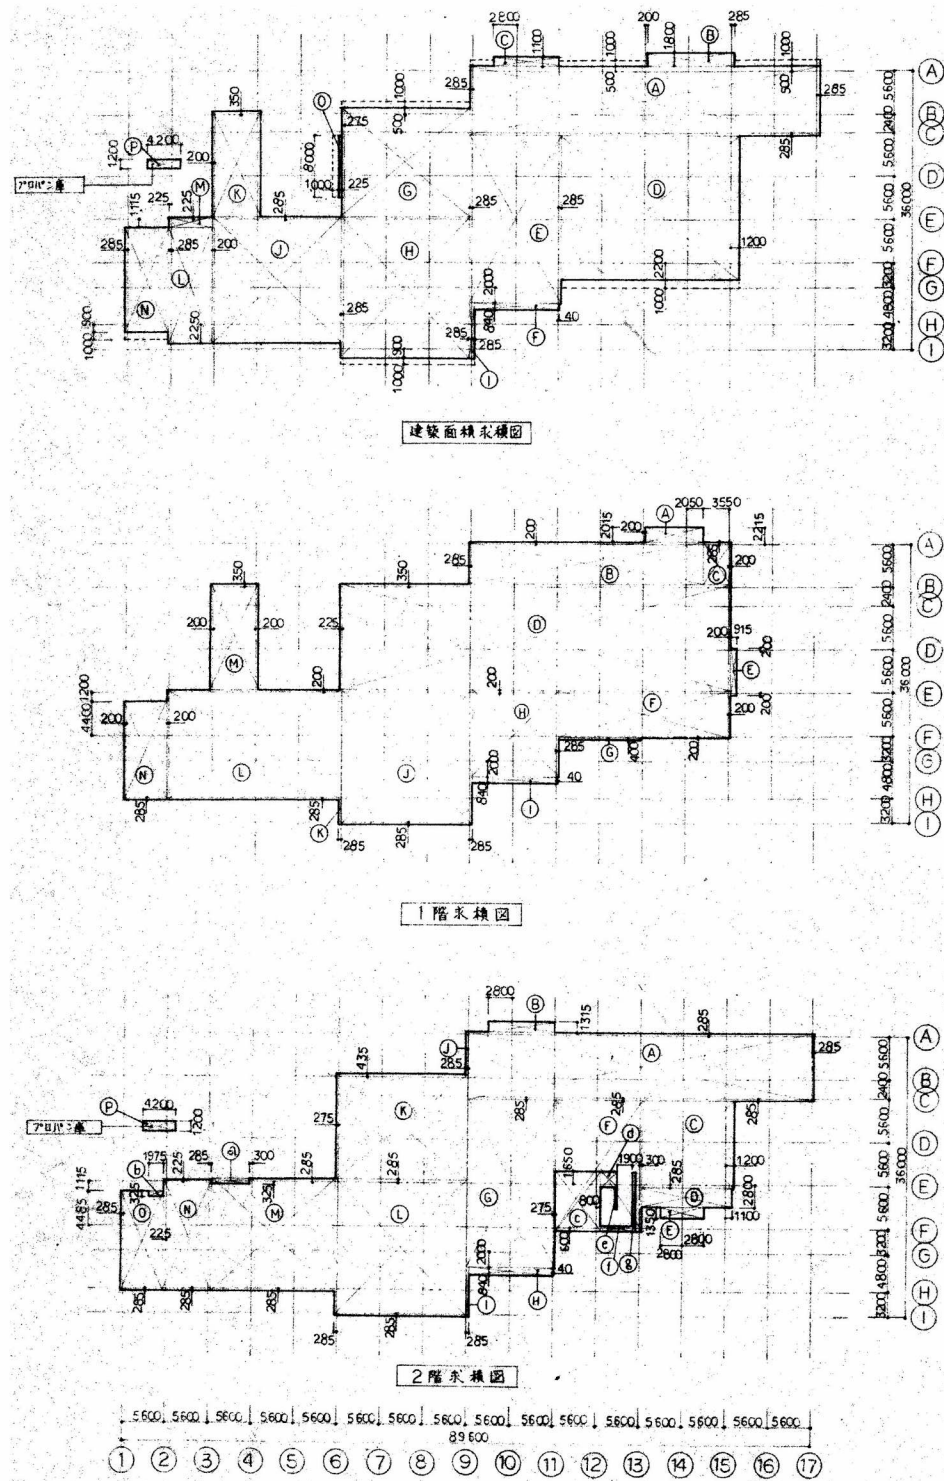

建築面積		
A	45.370 × 8.785	= 398.59
B	11.285 × 1.800	= 20.31
C	8.400 × 1.100	= 9.24
D	23.315 × 18.715	= 436.34
E	11.770 × 21.715	= 255.59
F	10.955 × .840	= 9.20
G	16.790 × 13.815	= 231.95
H	16.800 × 17.985	= 302.15
I	.570 × 6.900	= 3.93
L	16.715 × 16.135	= 269.70
K	6.000 × 13.665	= 81.99
L	5.685 × 14.735	= 83.77
M	5.625 × 1.340	= 7.54
N	5.600 × 13.385	= 74.96
O	.225 × 8.000	= 1.80
P	4.200 × 1.200	= 5.04
合計		= 2192.09

1 階		
A	7.450 × 2.015	= 15.01
B	30.335 × 5.450	= 165.33
C	3.750 × 5.450	= 20.44
D	50.825 × 13.750	= 698.84
E	.915 × 6.000	= 5.49
F	22.315 × 6.000	= 133.89
G	10.715 × .400	= 4.29
H	11.200 × 11.000	= 123.20
I	10.955 × .940	= 9.20
J	17.370 × 17.285	= 300.24
K	.285 × 3.285	= .94
L	22.600 × 14.085	= 318.32
M	6.000 × 13.750	= 82.50
N	5.600 × 12.885	= 71.04
A+B+C+D+E+F+G+H+I+J+K+L+M+N		= 1948.73

3 階		
A	45.370 × 8.570	= 388.82
D	8.535 × 2.015	= 17.20
E	11.770 × 10.630	= 125.12
F	9.715 × 2.330	= 22.64
G	25.485 × 9.370	= 238.79
H	11.200 × 1.715	= 19.21
I	10.955 × .840	= 9.20
J	6.170 × 8.000	= 49.36
L	19.600 × 16.135	= 316.25
M	5.885 × 14.735	= 86.72
K	5.825 × 1.340	= 7.81
L	5.600 × 4.770	= 26.71
A+B+C+D+E+F+G+H+I+J+K+L		= 1107.82

求面積	
1 階	1948.73
2 階	1085.71
3 階	1107.82
P1 階	189.36
合計	5331.63

2 階		
A	45.085 × 8.570	= 386.36
B	8.400 × 1.315	= 11.05
C	12.100 × 11.200	= 135.52
D	12.000 × 2.515	= 30.18
E	5.600 × 1.350	= 7.56
F	11.225 × 17.115	= 192.12
G	11.475 × 21.715	= 249.18
H	10.955 × .840	= 9.20
I	285 × 6.305	= 1.80
J	285 × 5.450	= 1.55
K	17.075 × 13.750	= 234.78
L	17.085 × 17.370	= 296.77
M	16.230 × 14.170	= 229.98
N	6.110 × 14.110	= 86.21
O	5.660 × 12.770	= 72.28
P	5.015 × .610	= 3.06
Q	1.975 × .610	= 1.20
R	6.125 × 7.850	= 48.08
S	2.100 × 2.100	= 4.41
T	.200 × 3.000	= .60
U	4.425 × .800	= 3.54
V	.425 × 7.050	= 3.00
A+B+C+D+E+F+G+H+I+J+K+L+M+N+O+P+Q+R+S+T+U+V		= 1885.71
P1 階		
A	2.935 × 6.135	= 18.01
B	3.235 × 5.085	= 16.45
C	14.285 × 6.170	= 88.14
D	8.345 × 8.000	= 66.76
A+B+C+D		= 169.36