

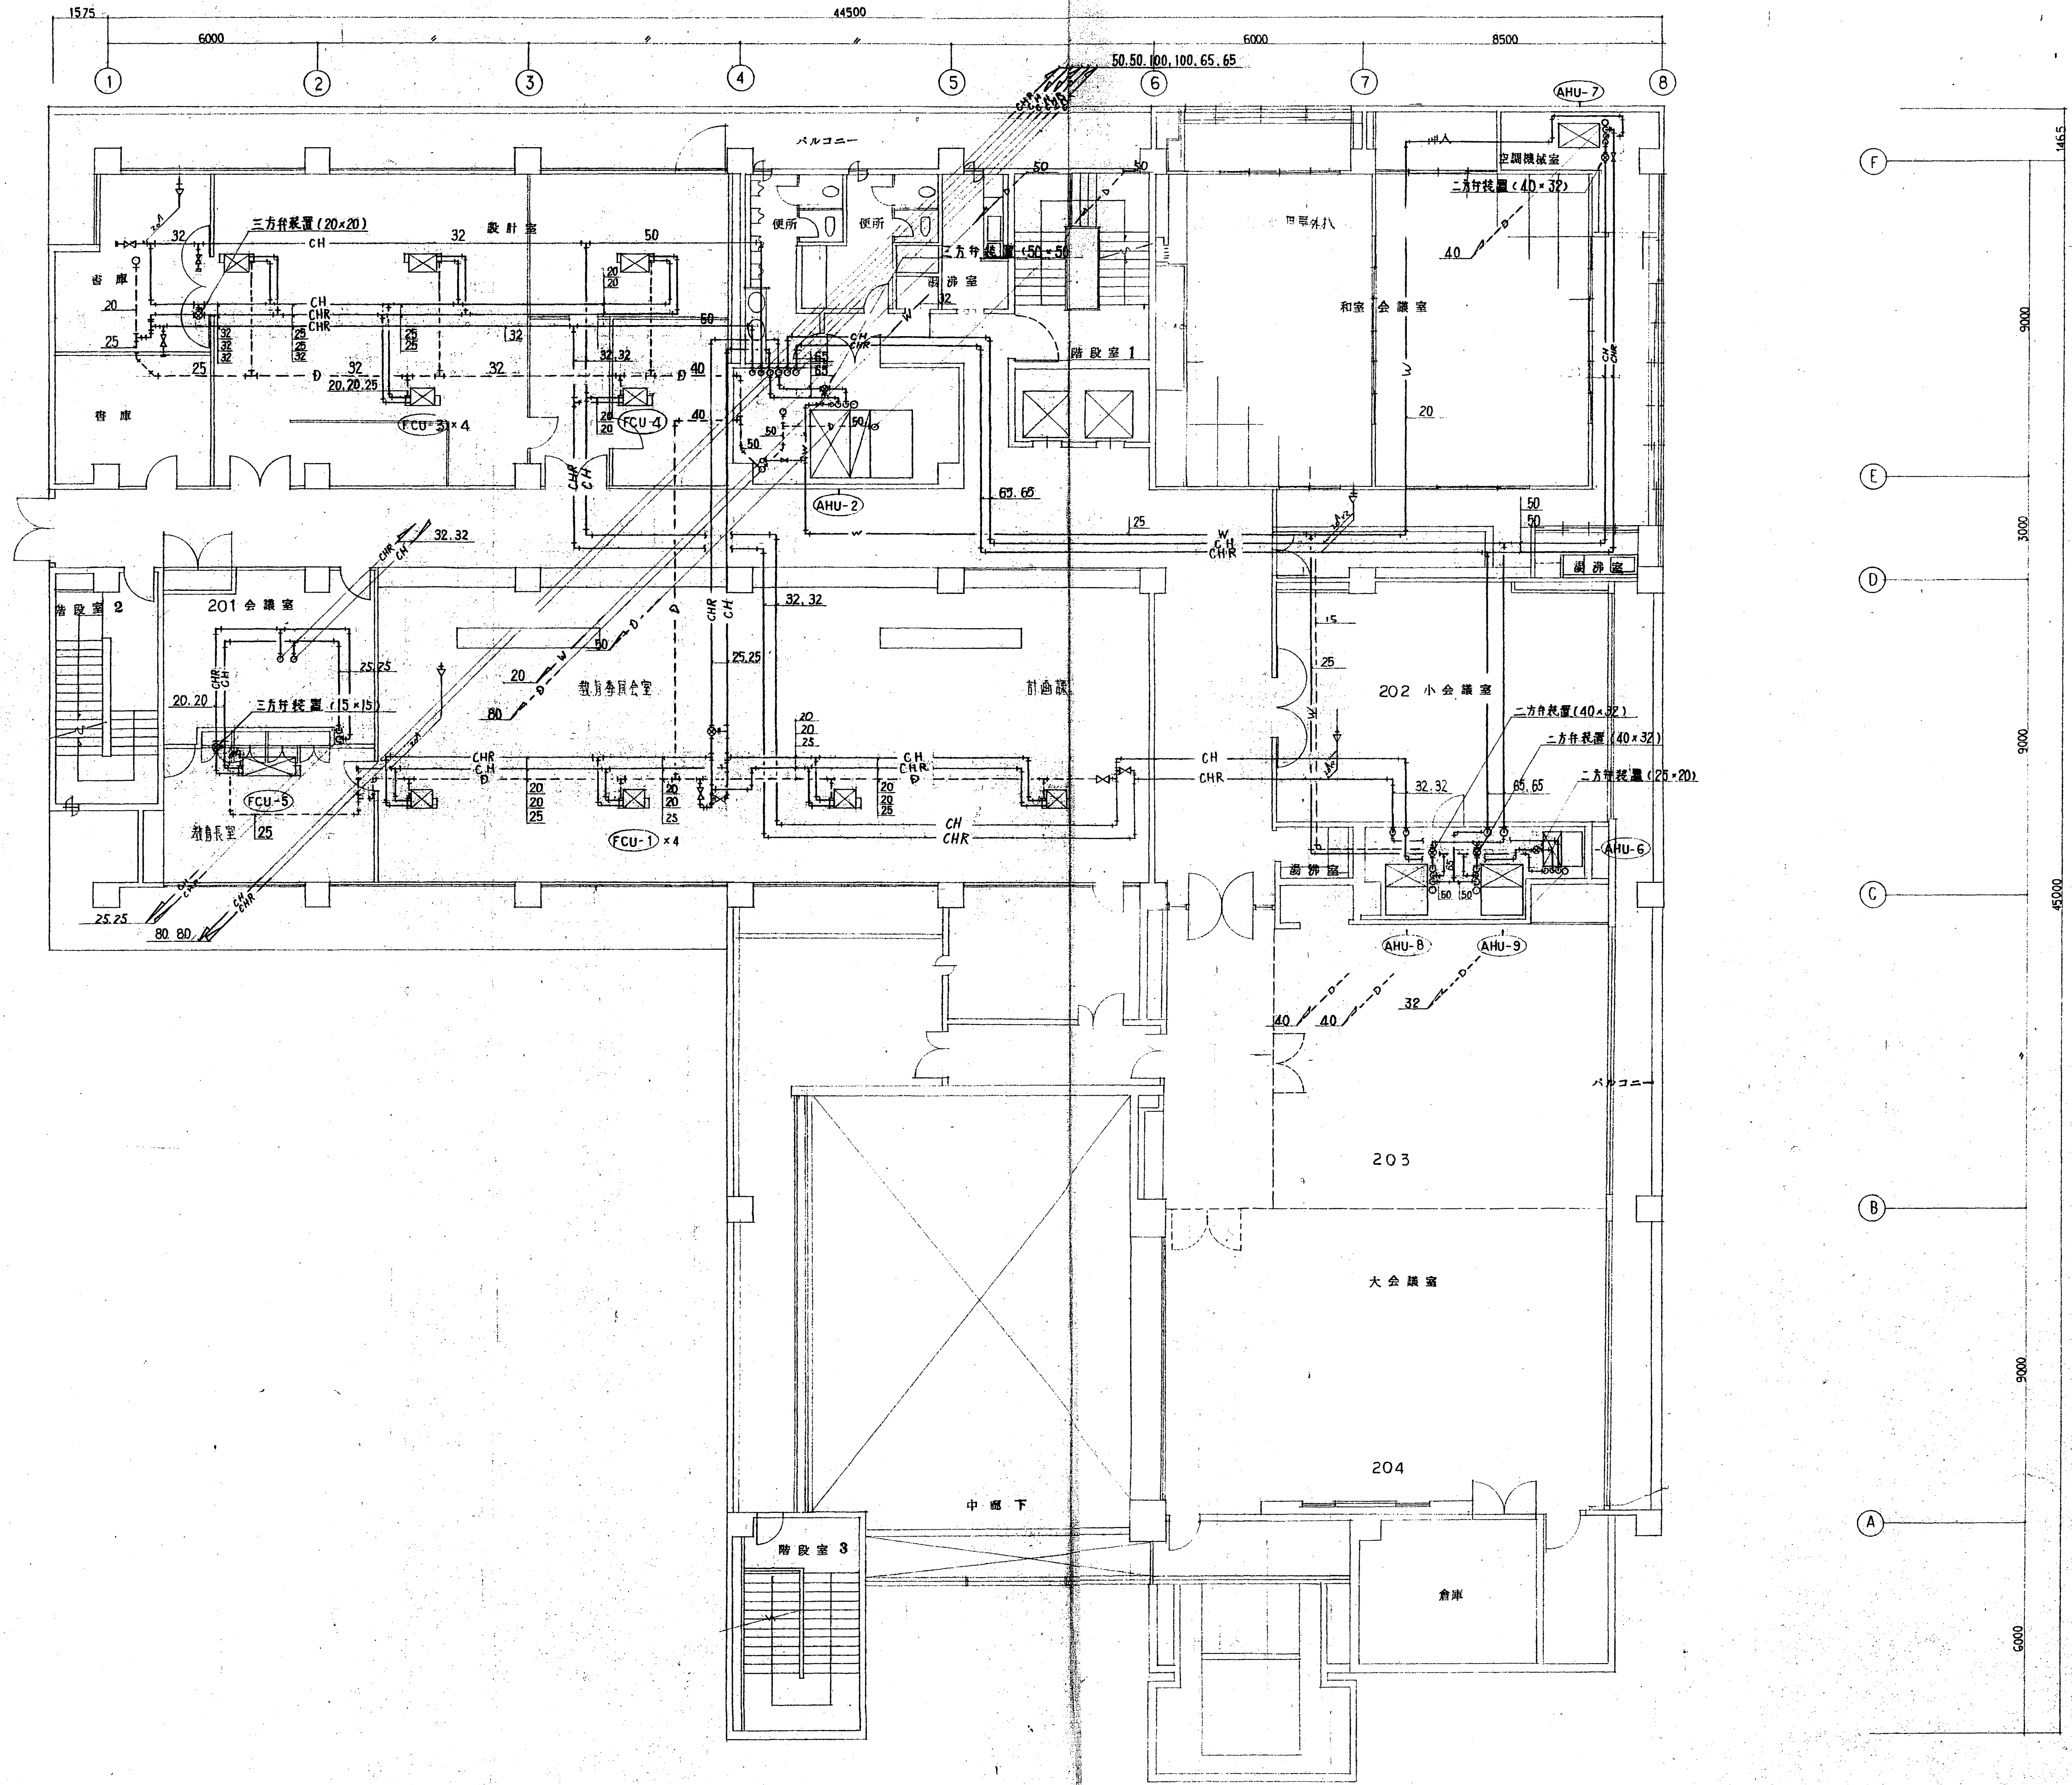






竣工図

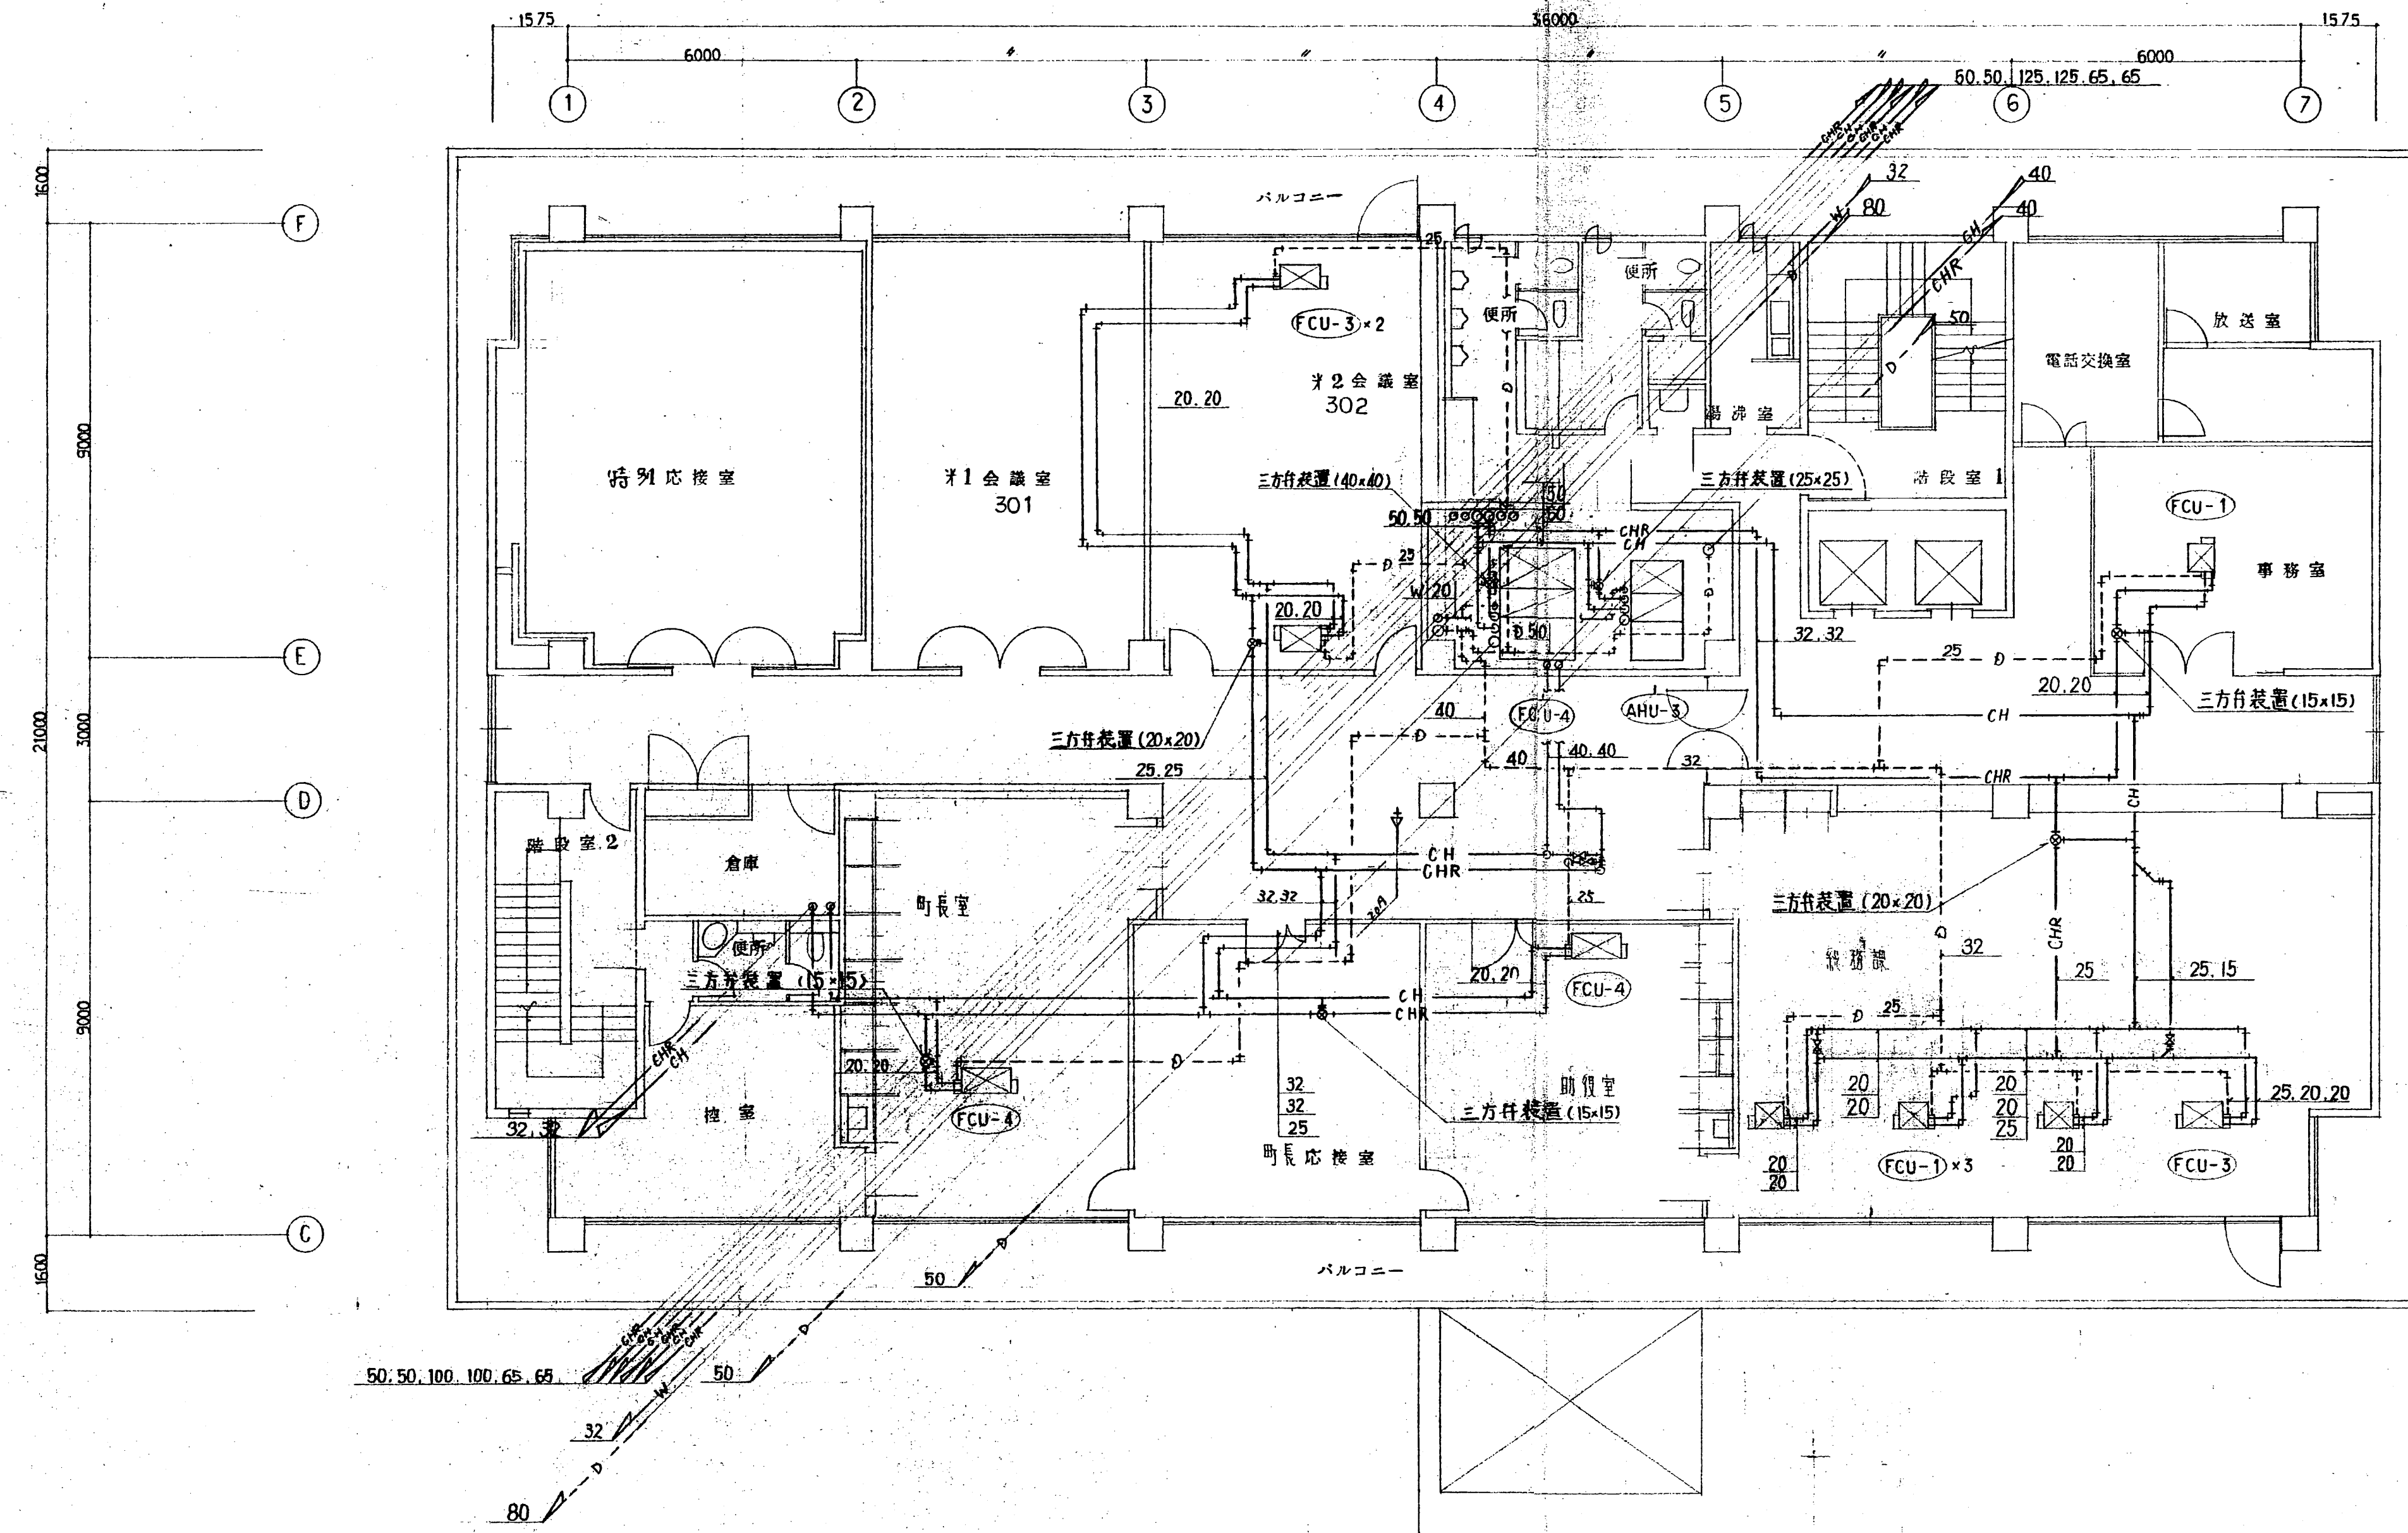


竣工図

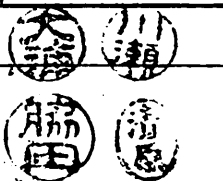



竣工図

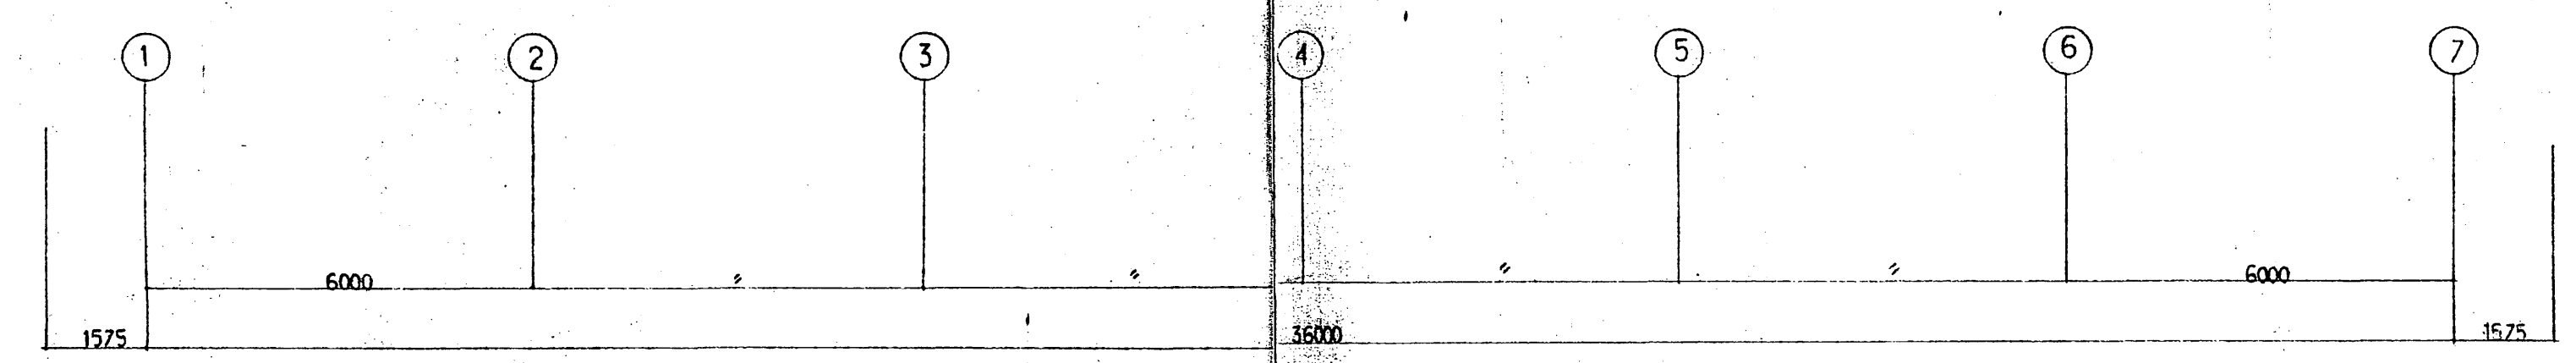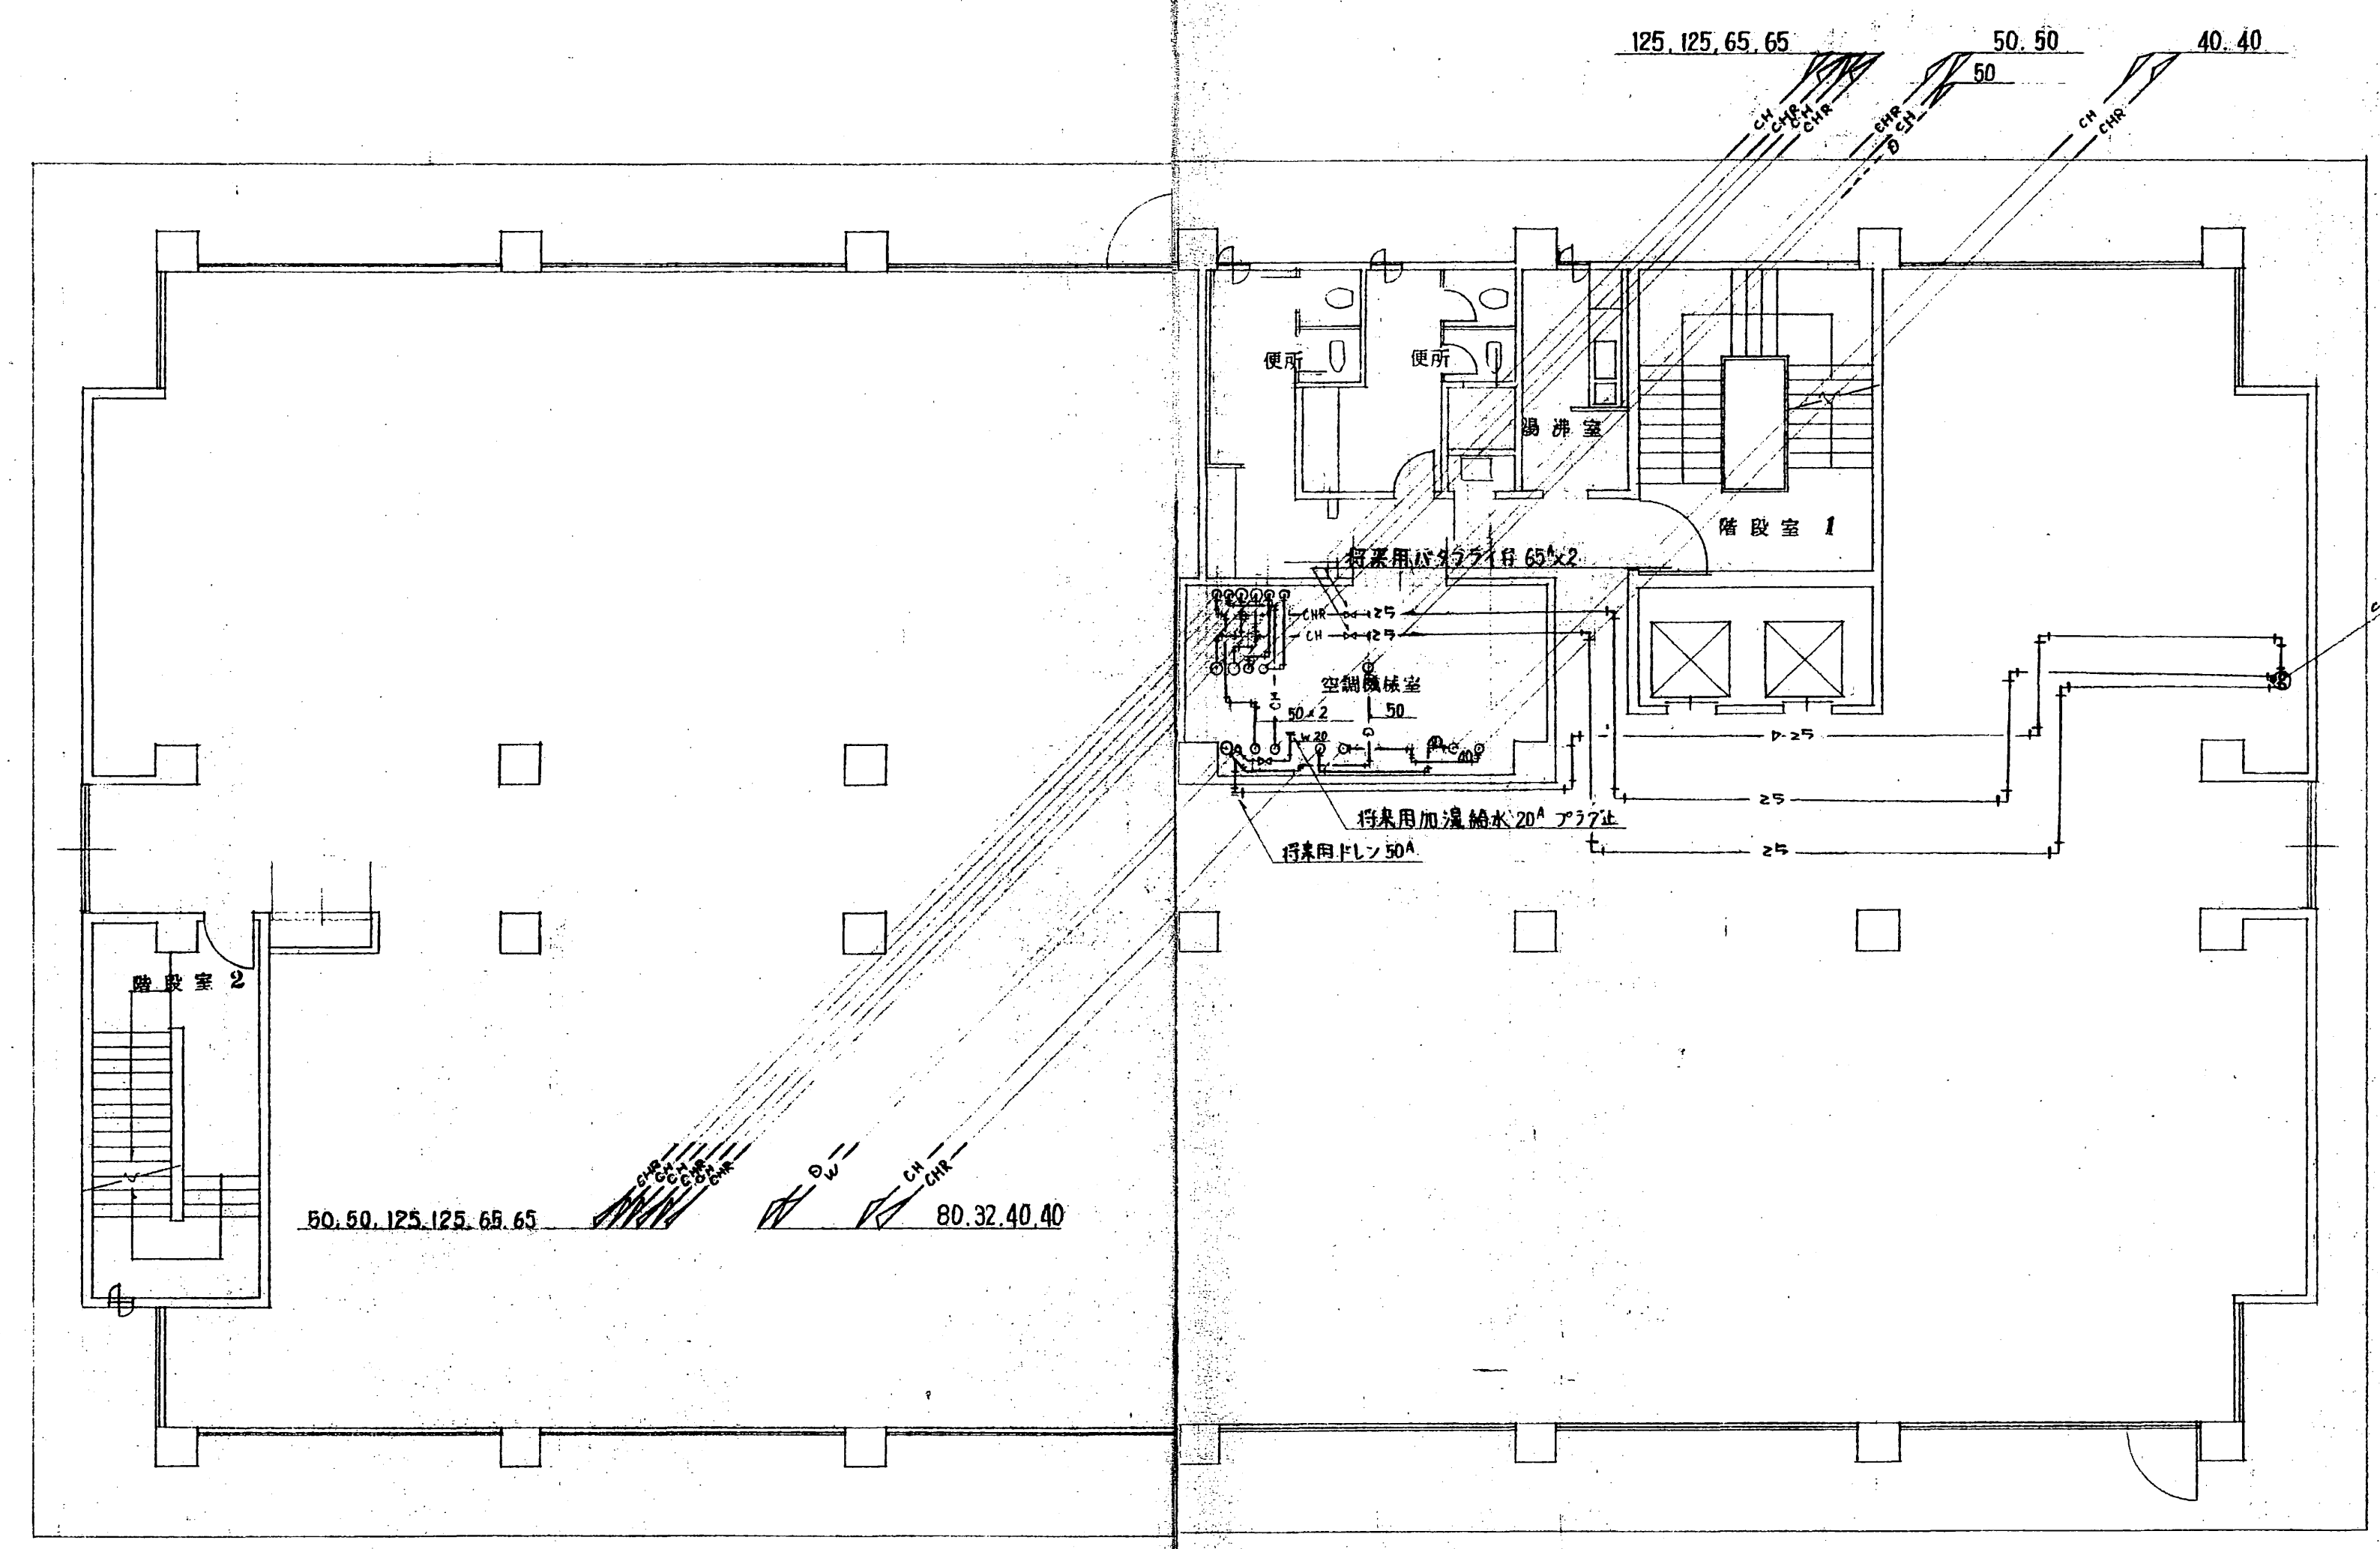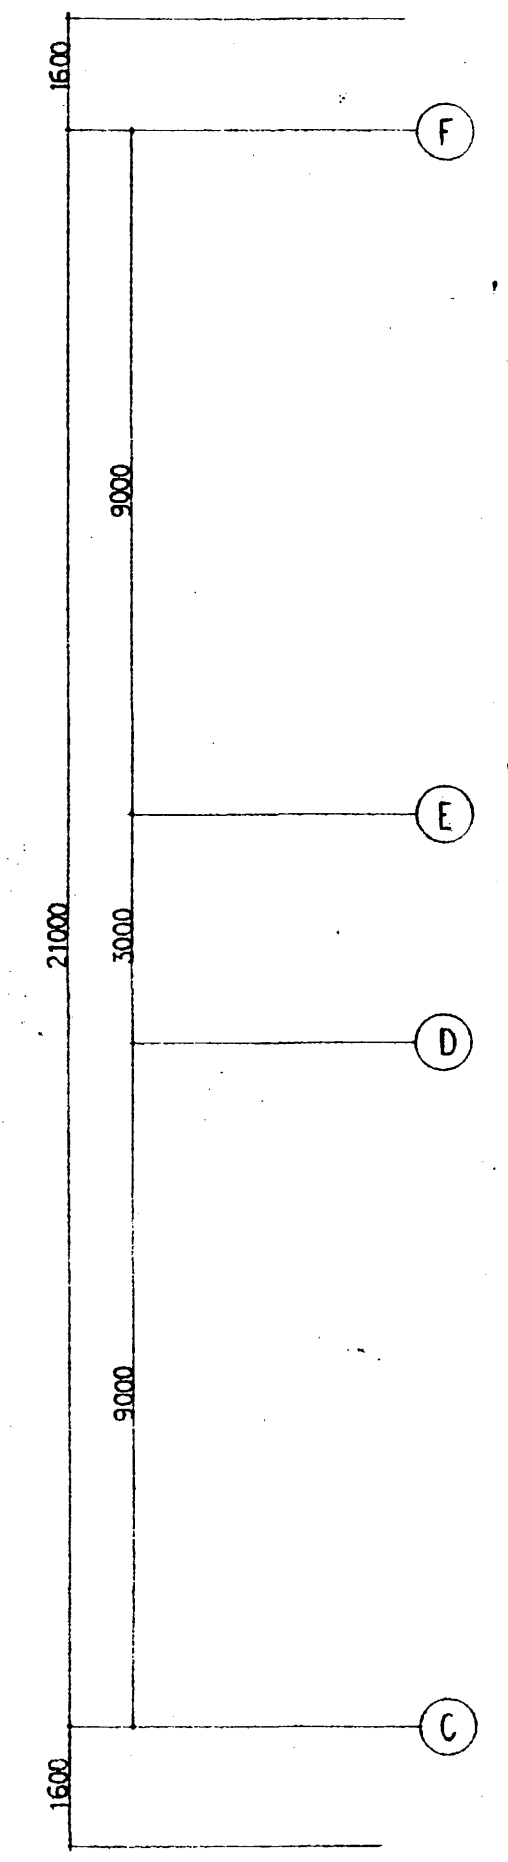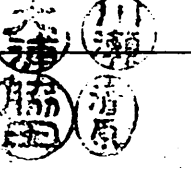


竣工図

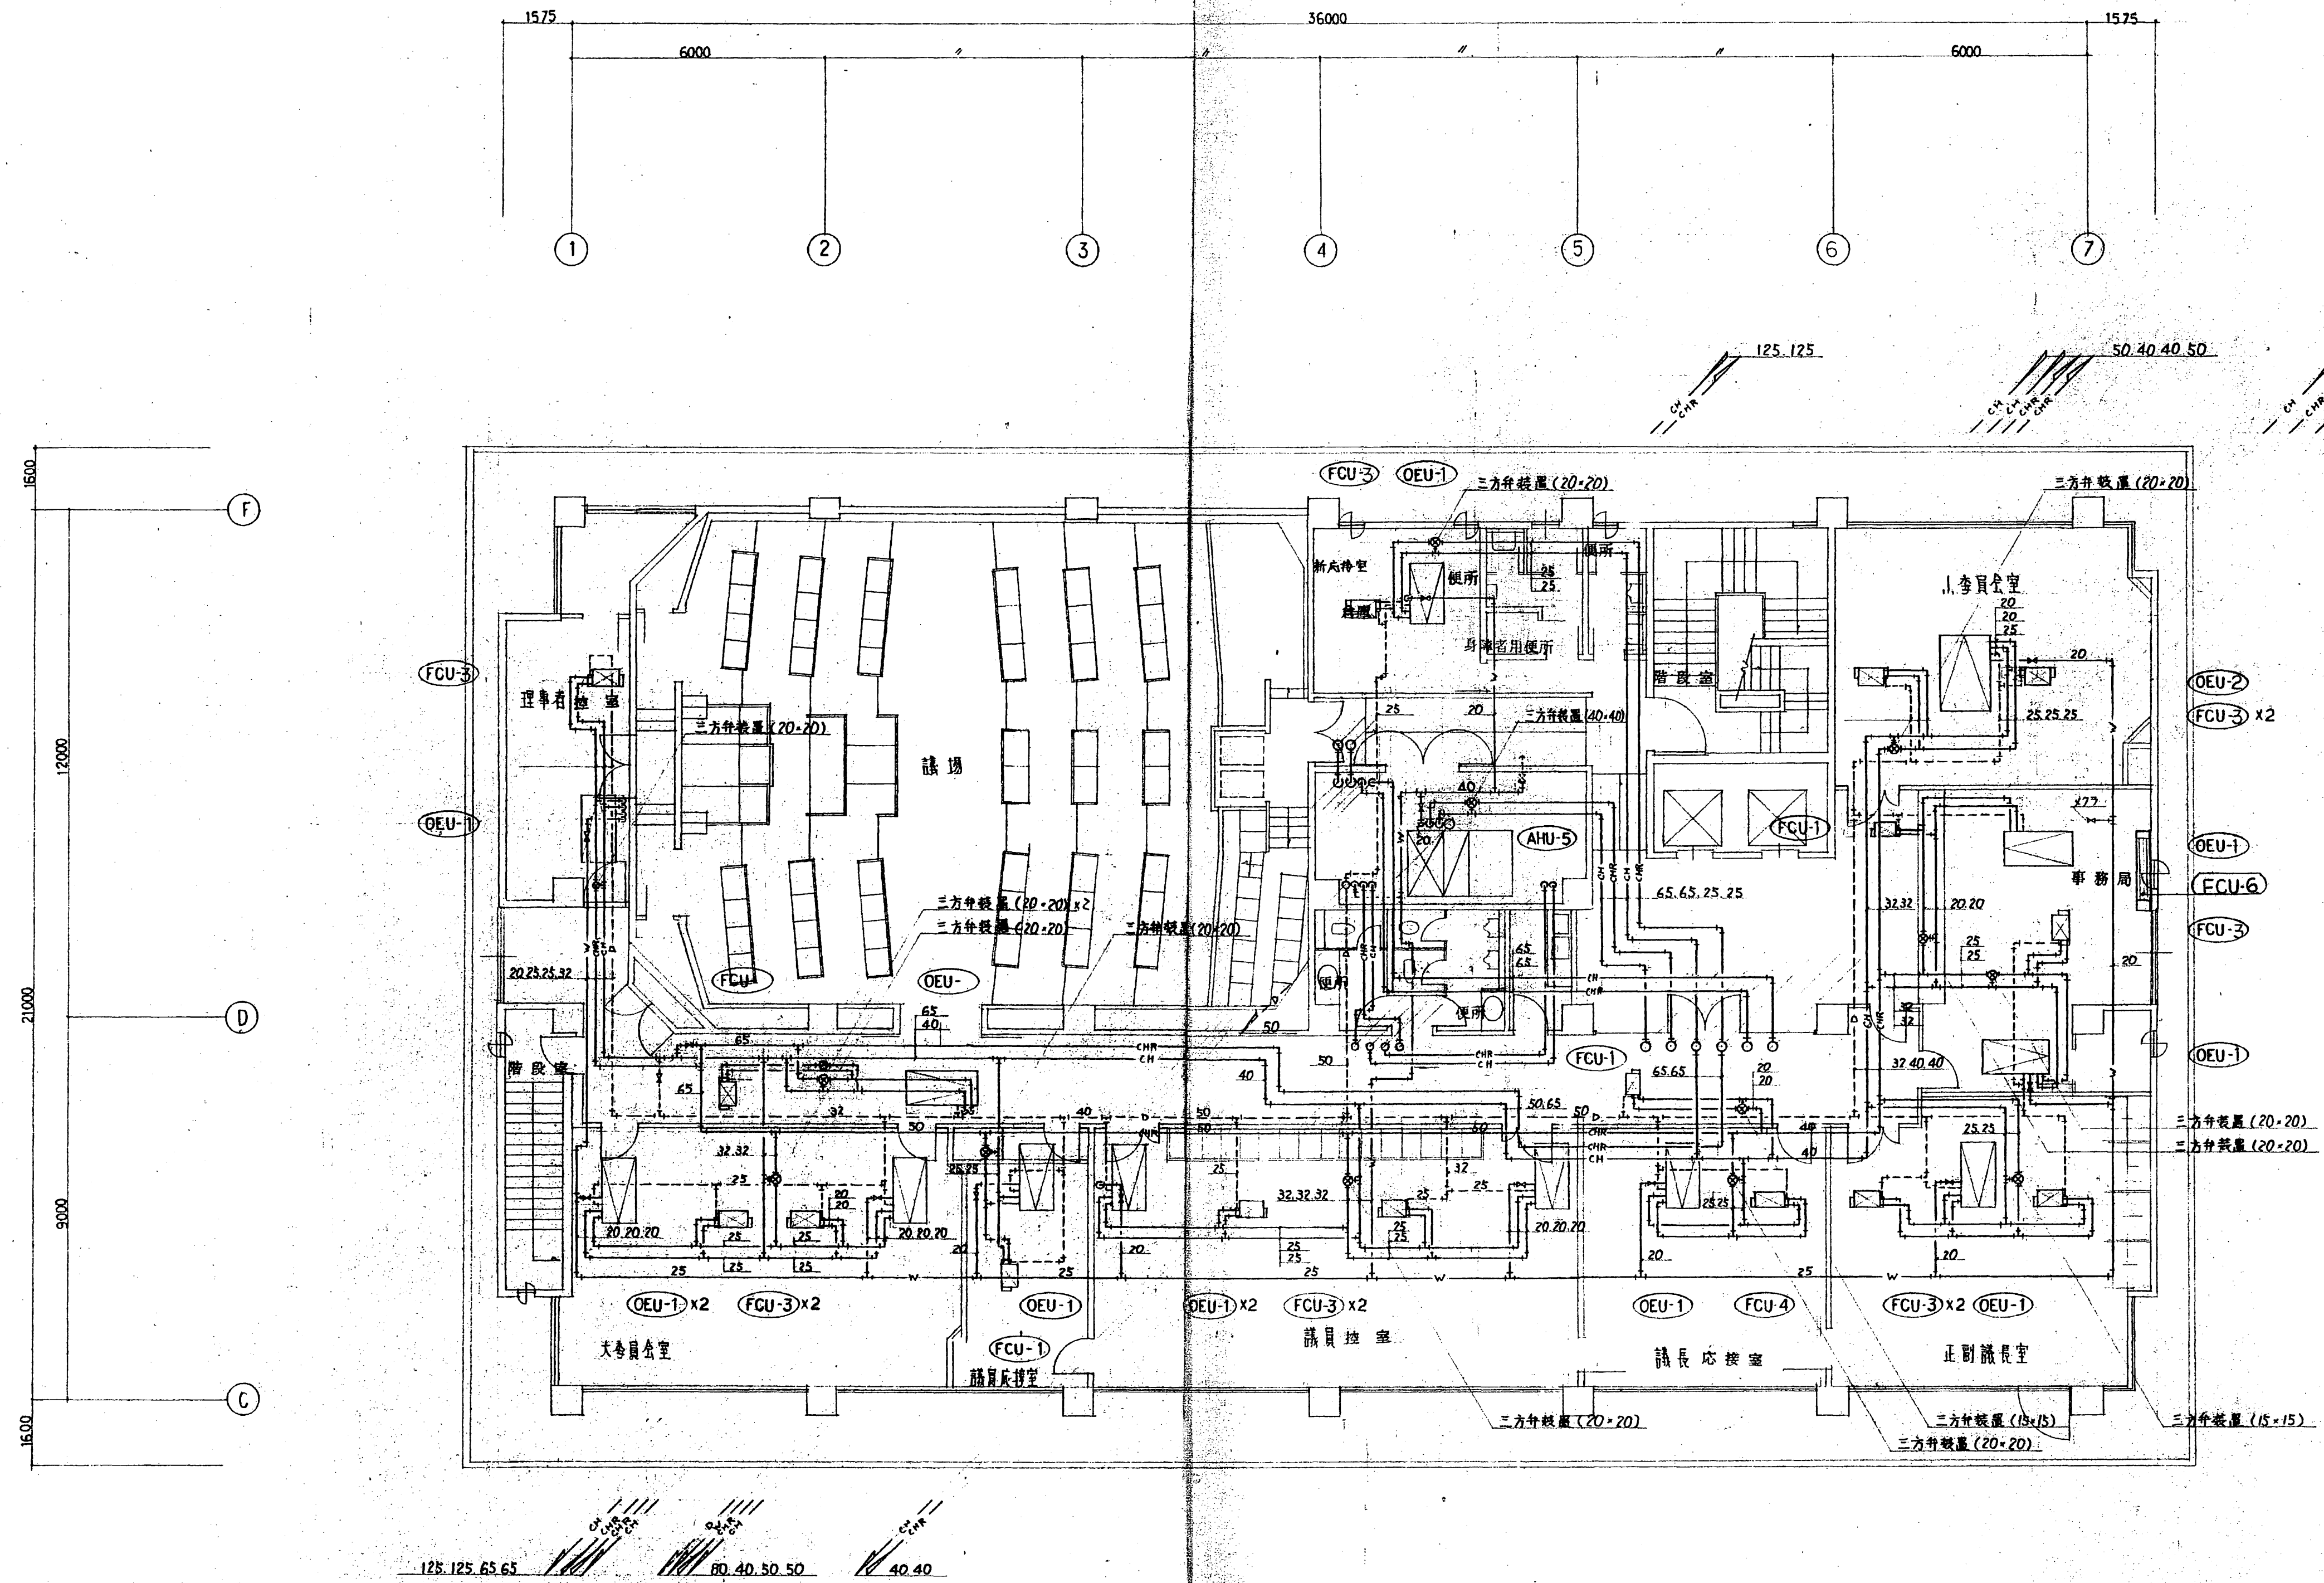


竣工図

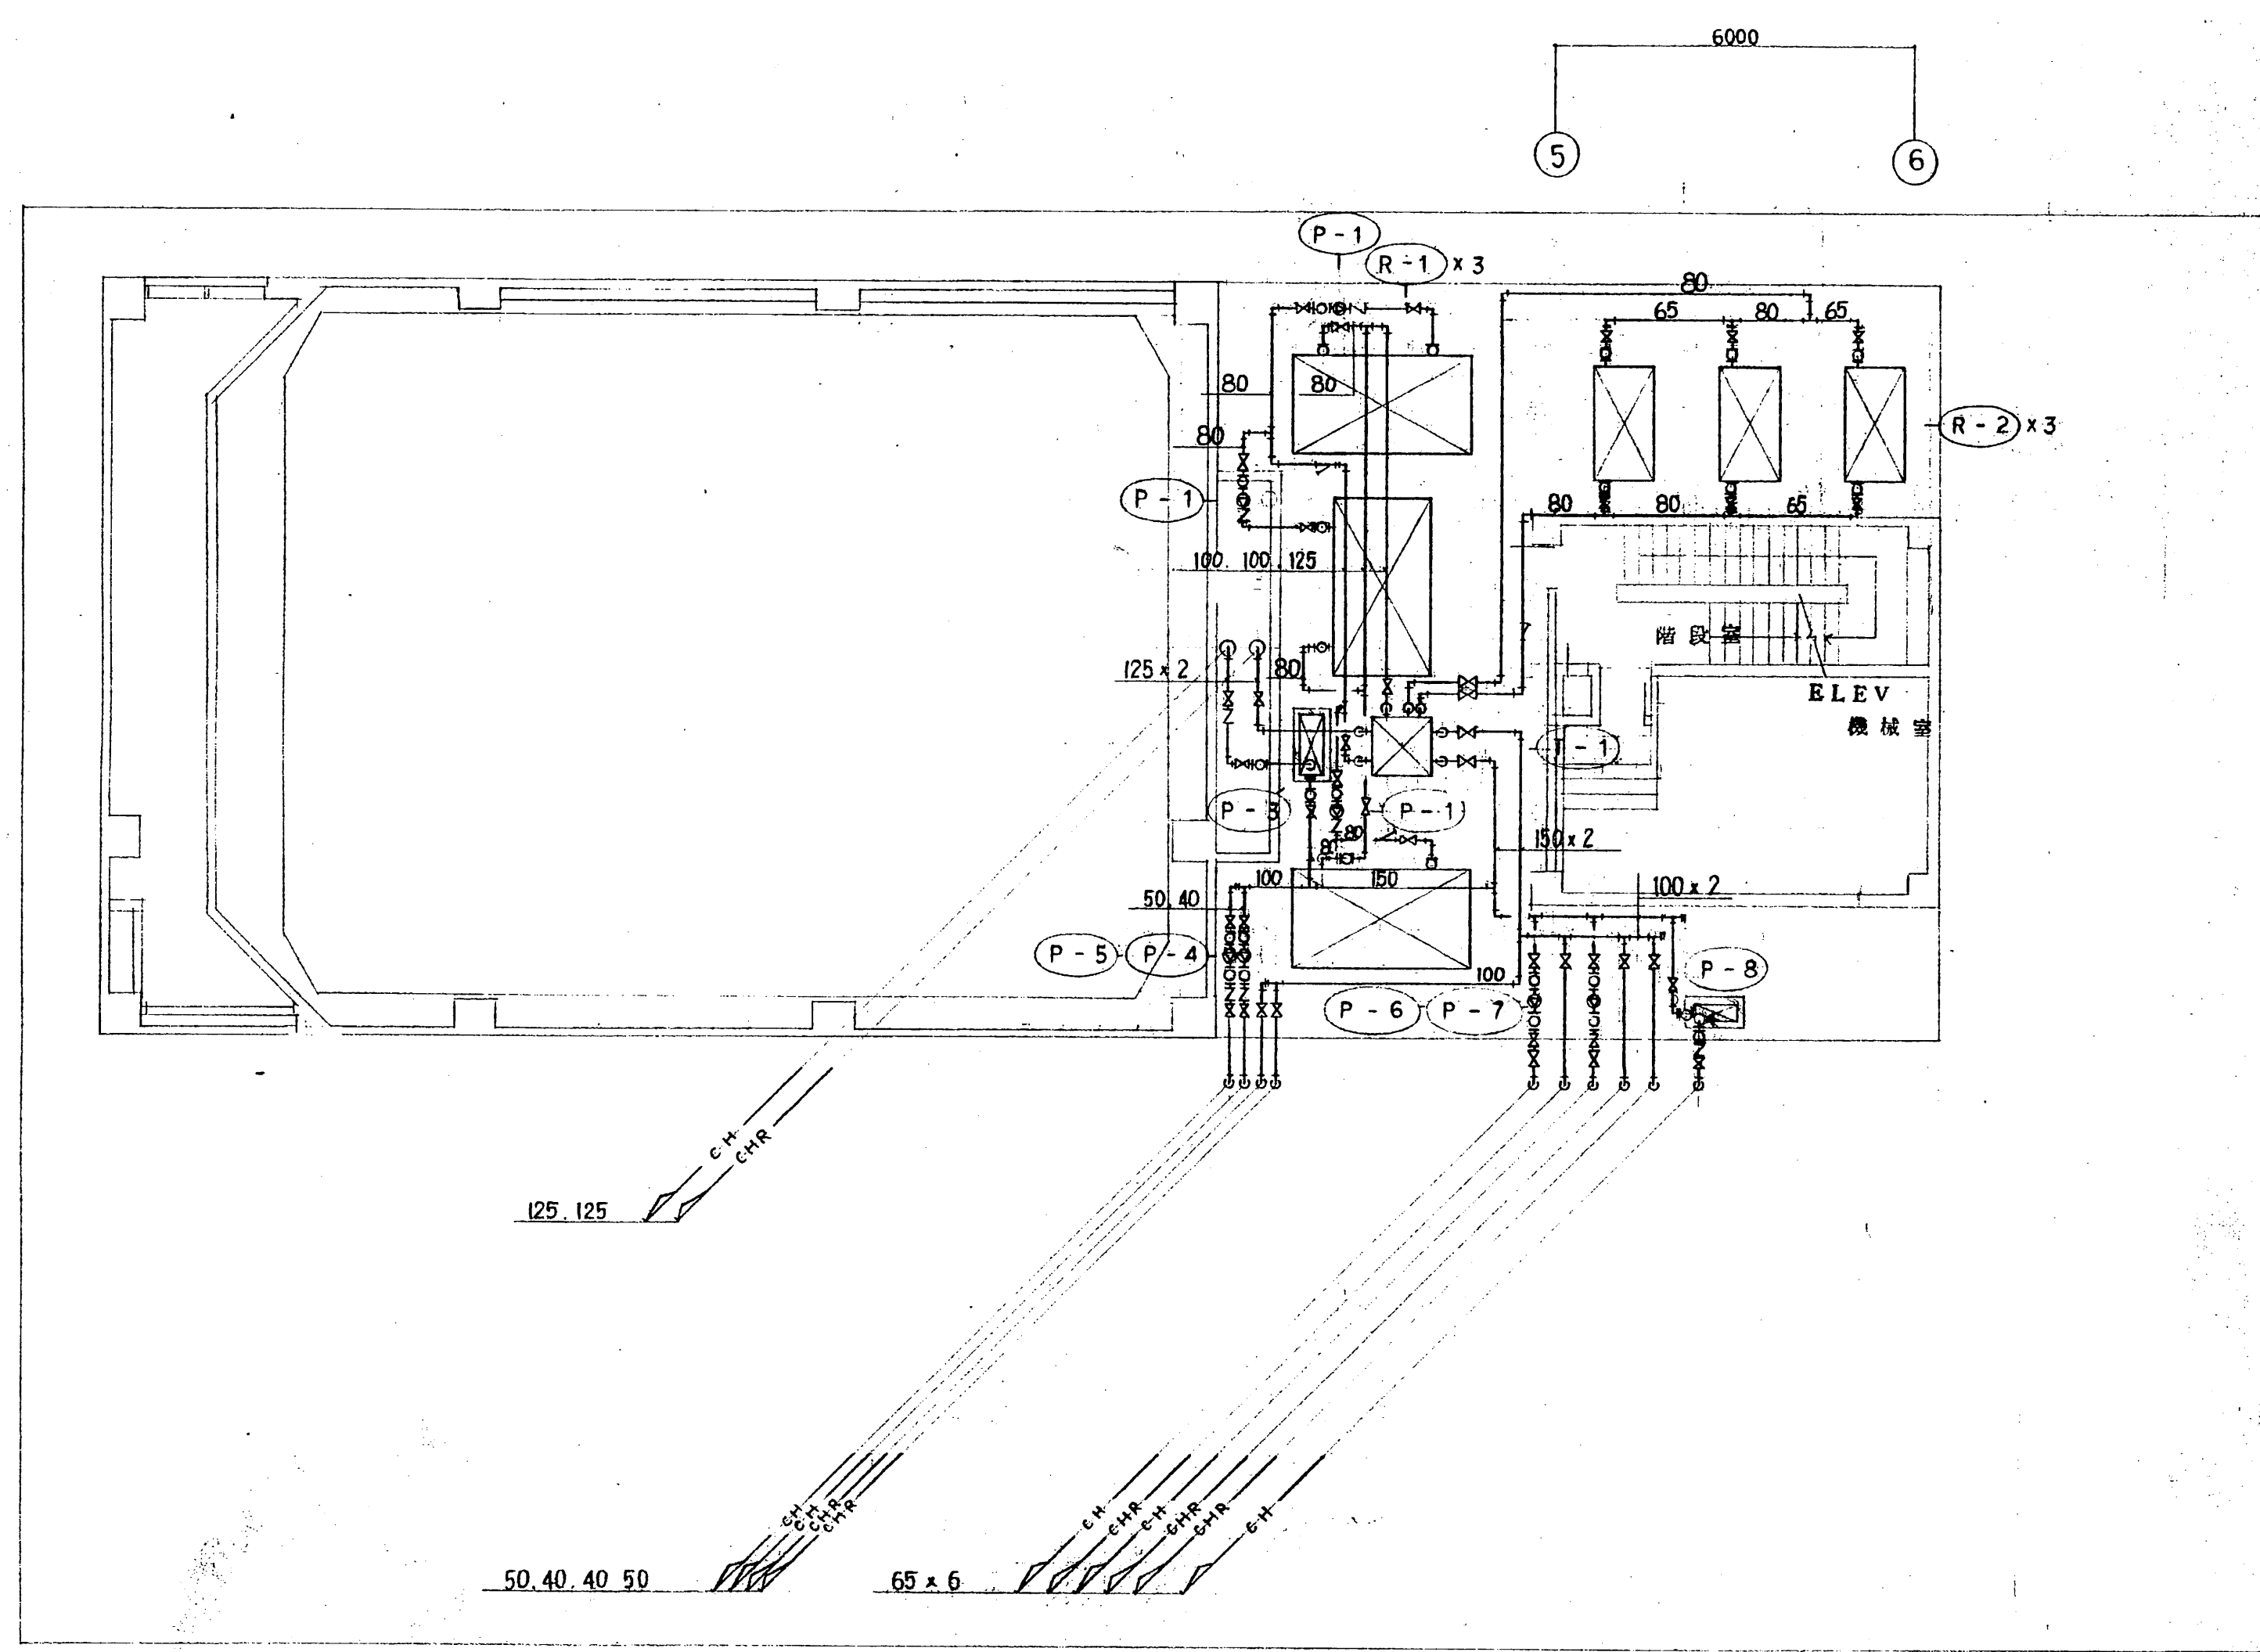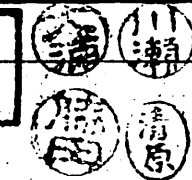


6階平面図 1:100

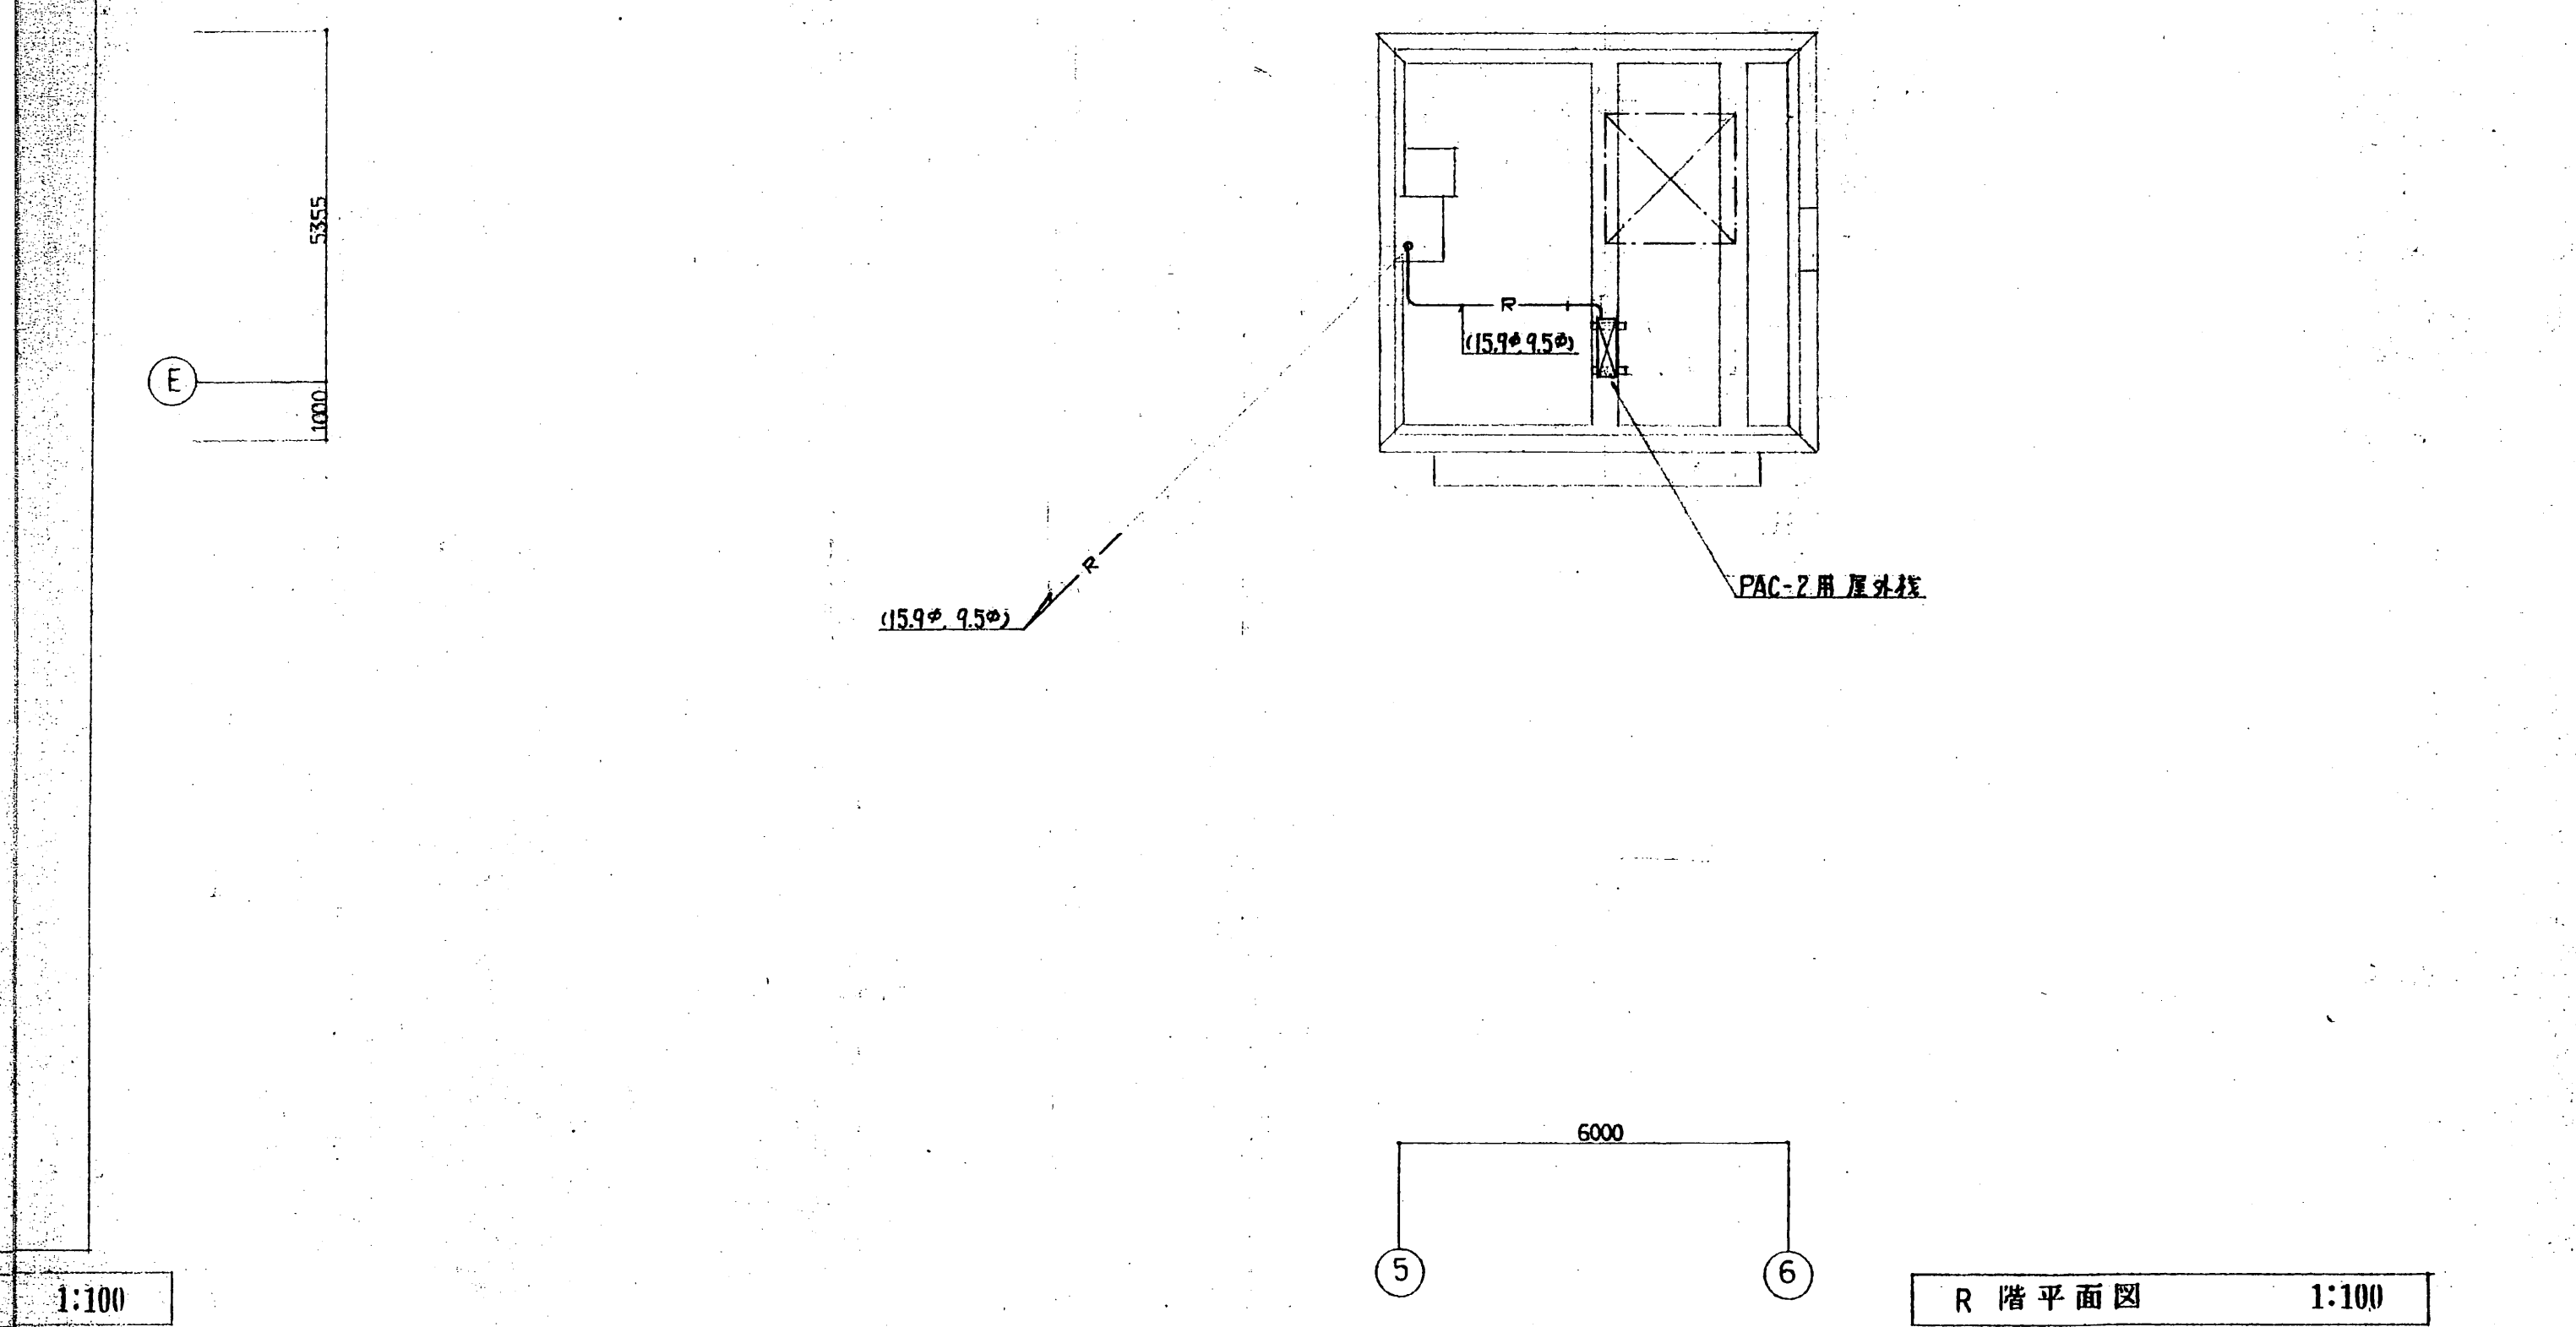


R階平面図 1:100

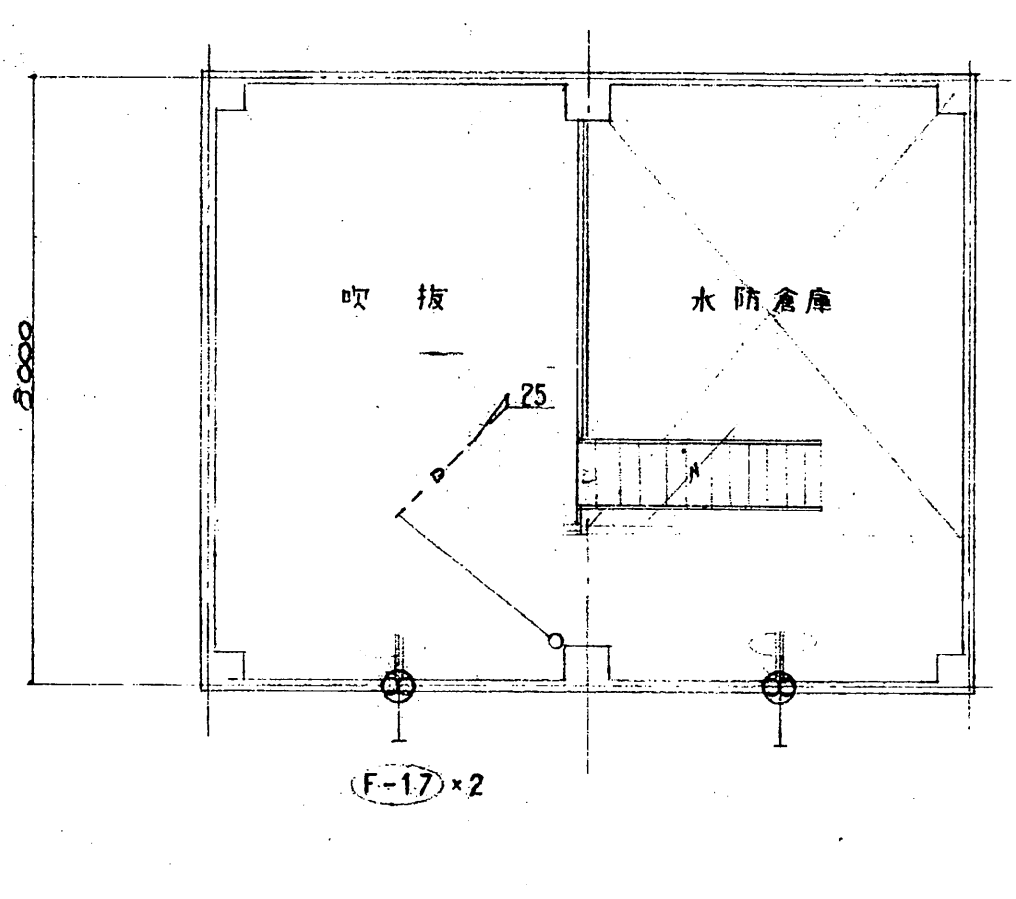

中2階平面図 1:100

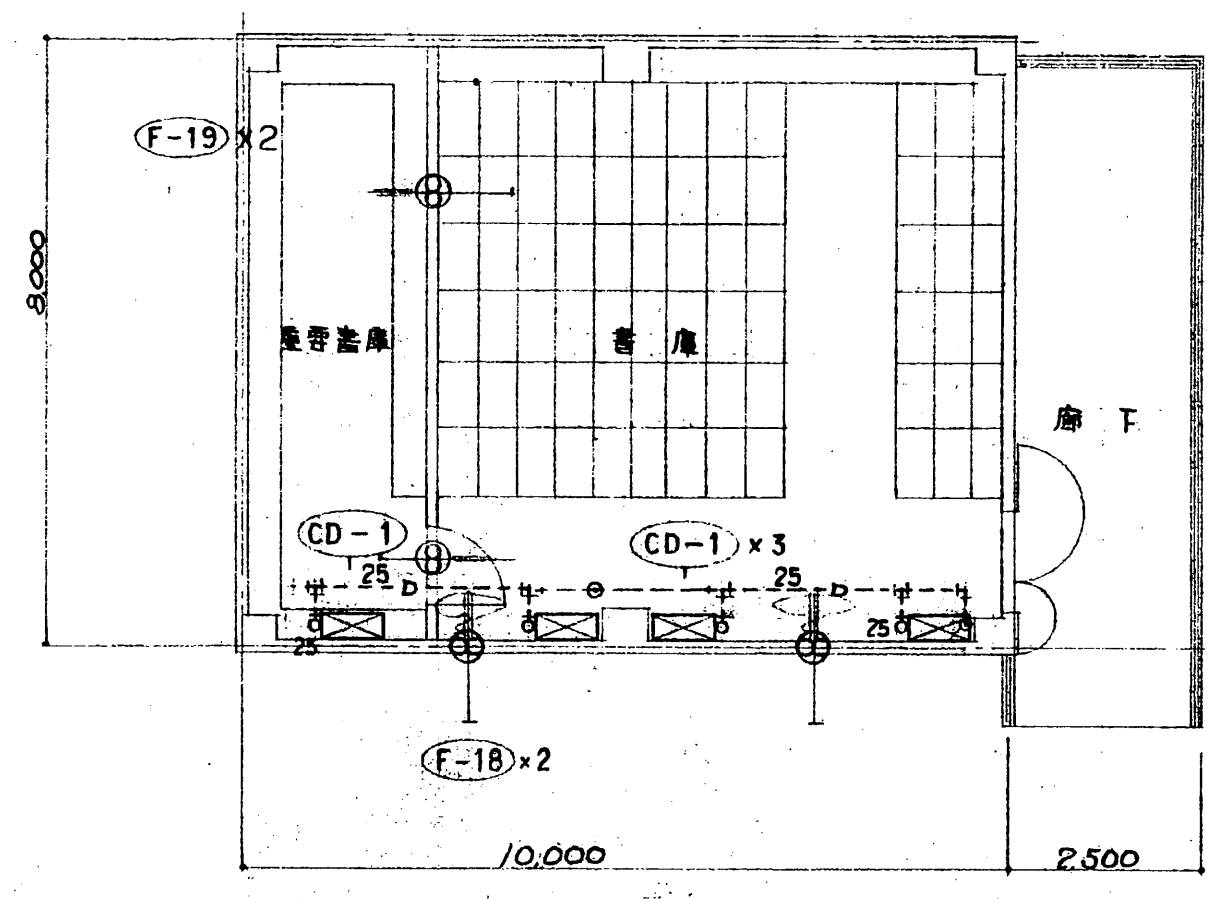


2階平面図 1:100

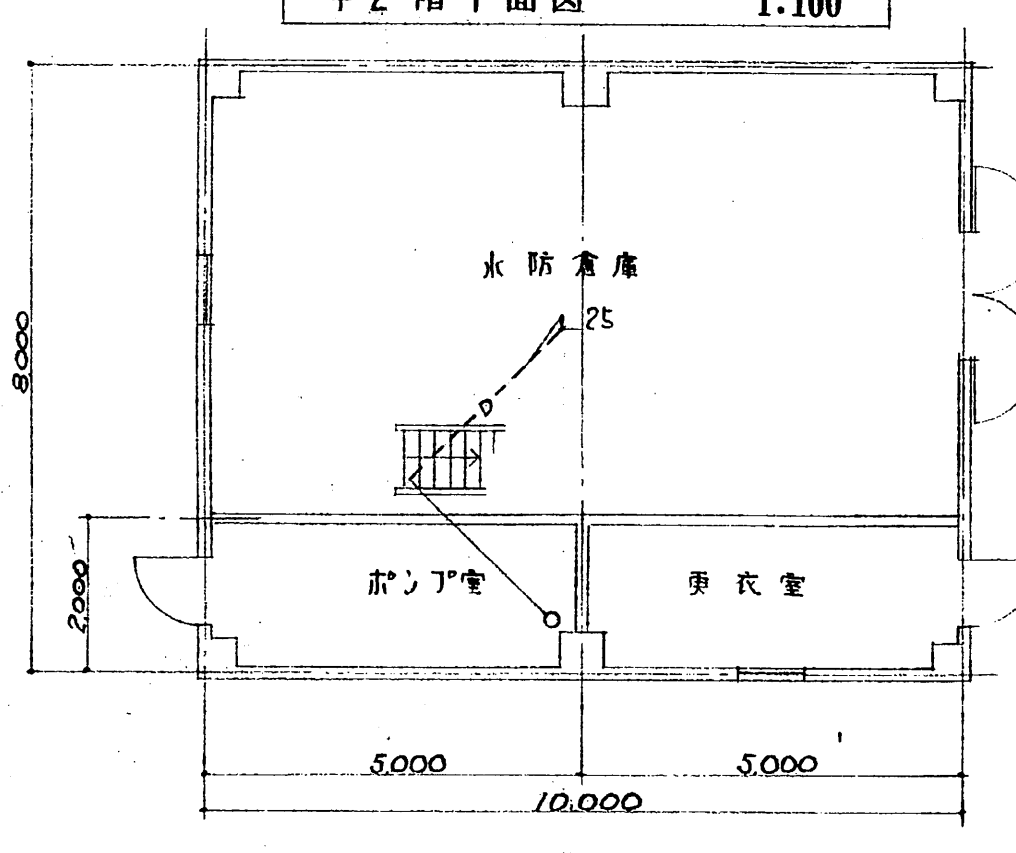

1階平面図 1:100

附属機平面図

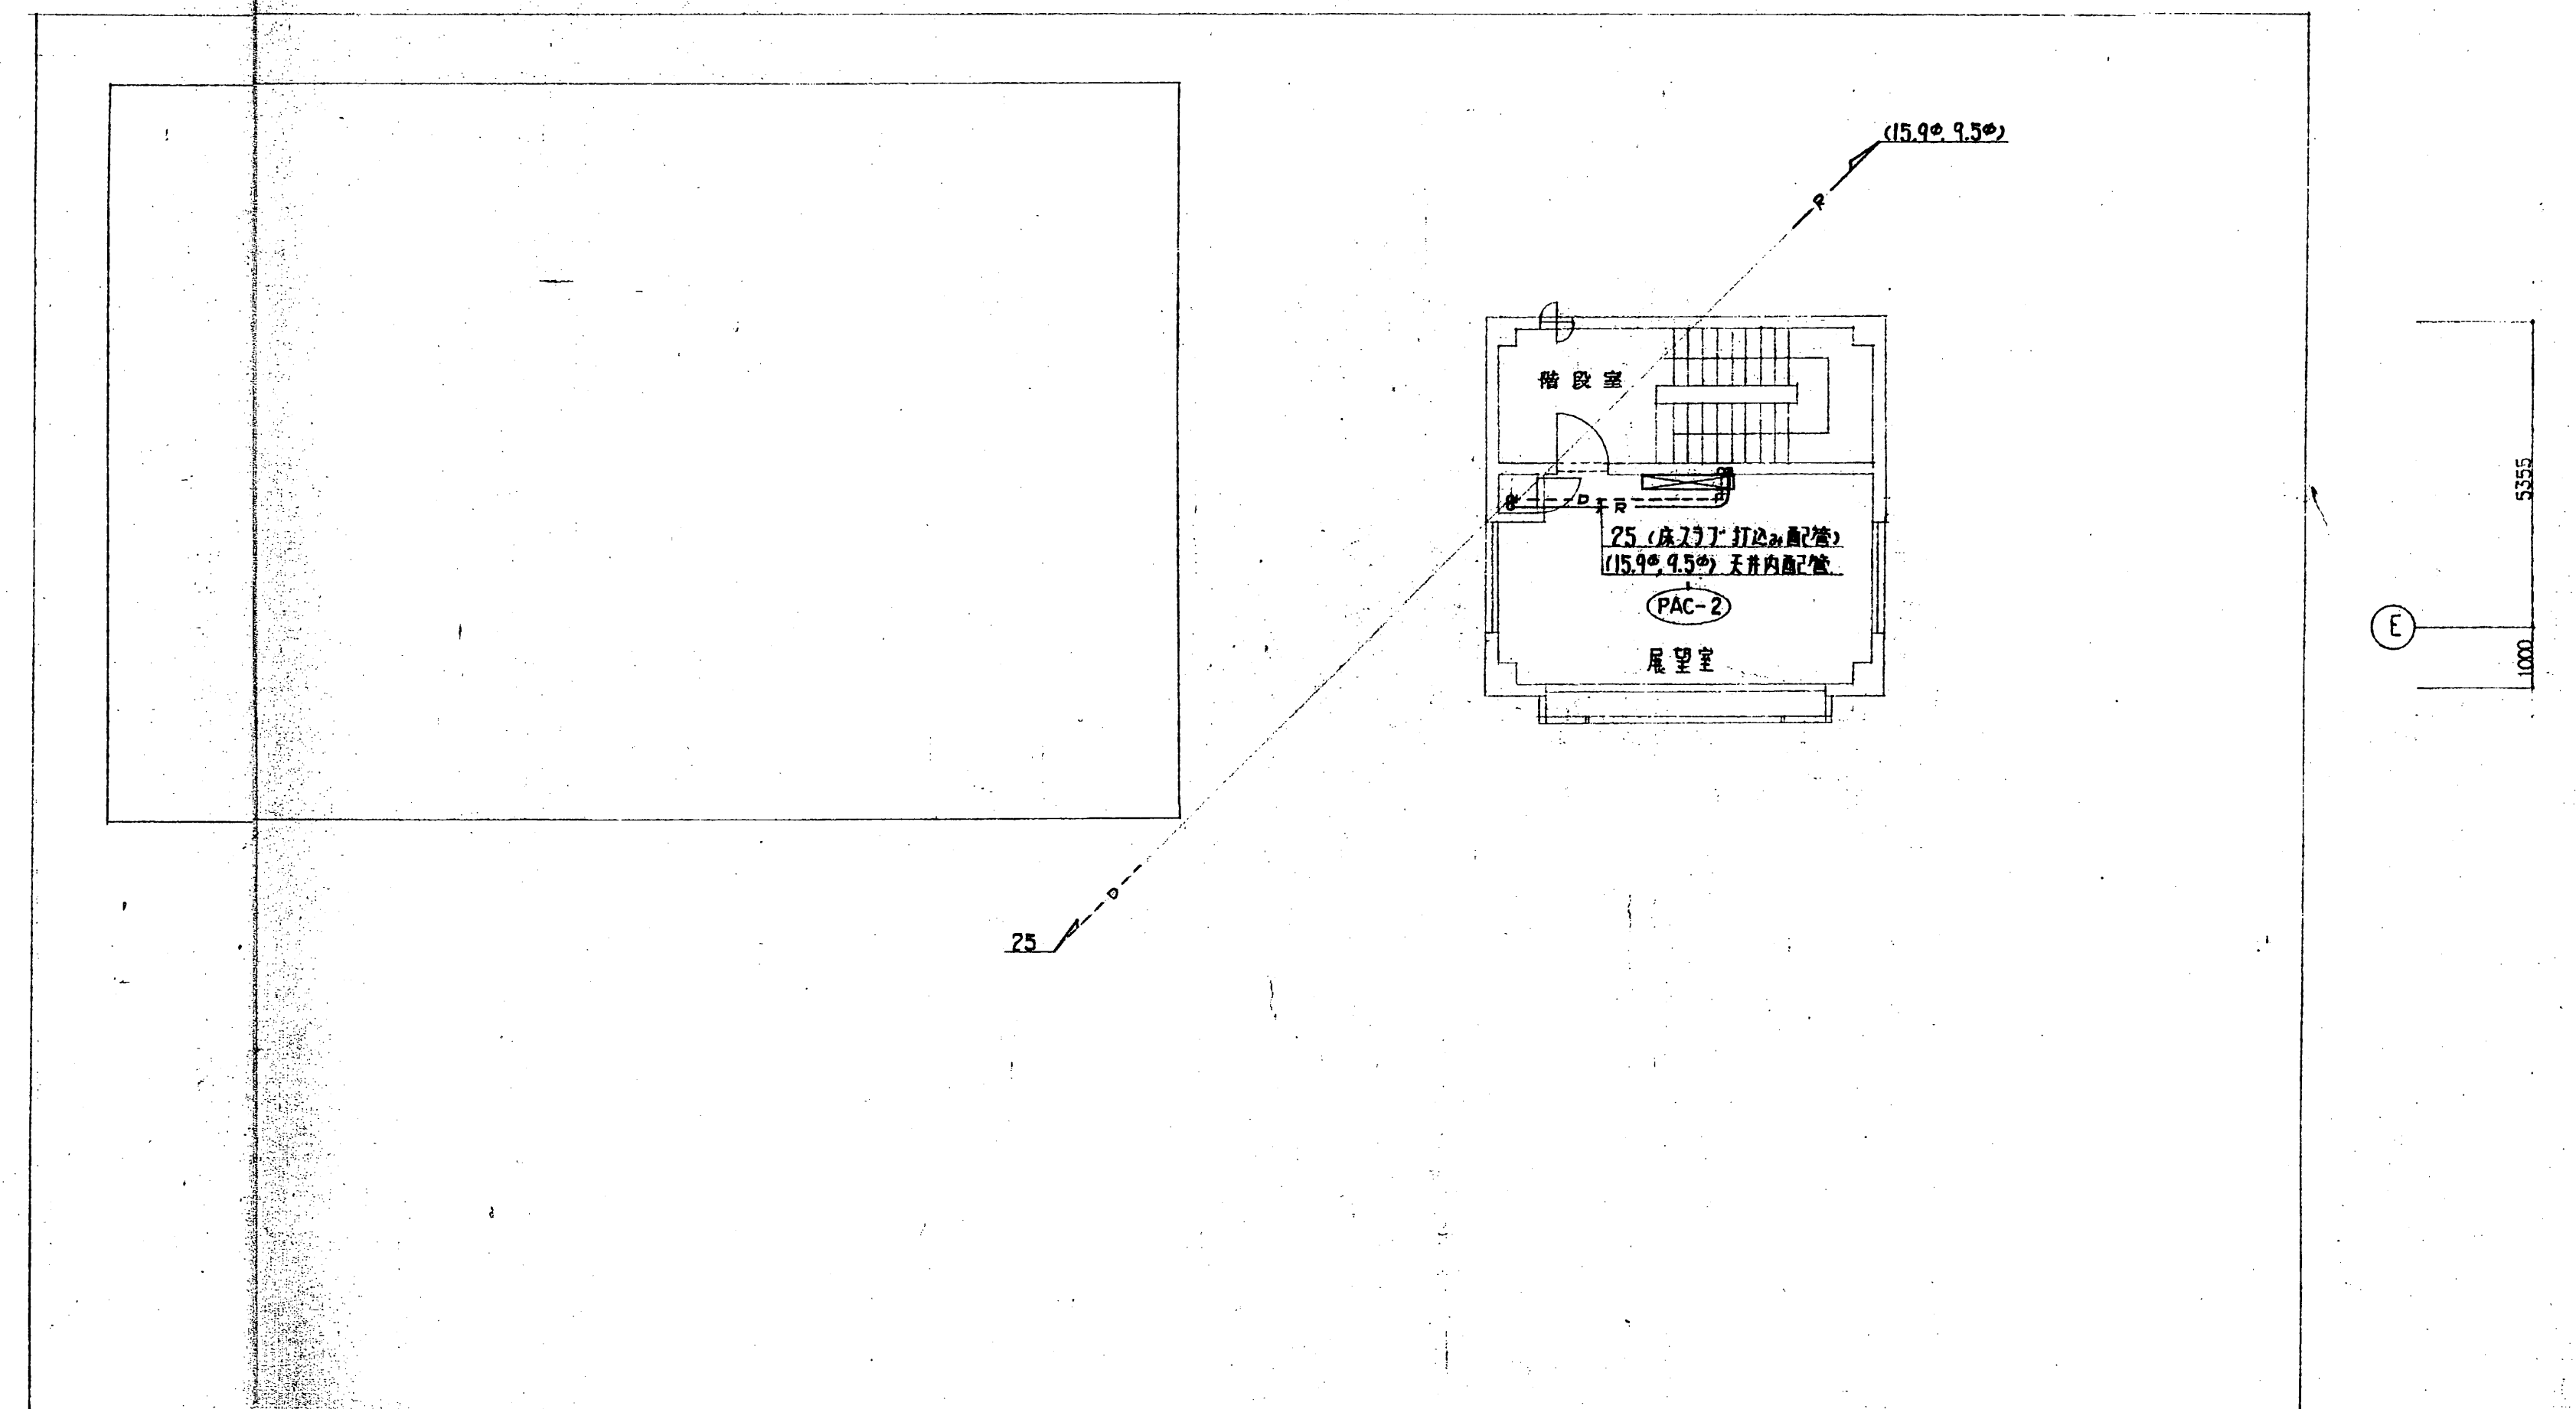

7階平面図 1:100